


T. 25 & 26 S., R. 35E., W.M.

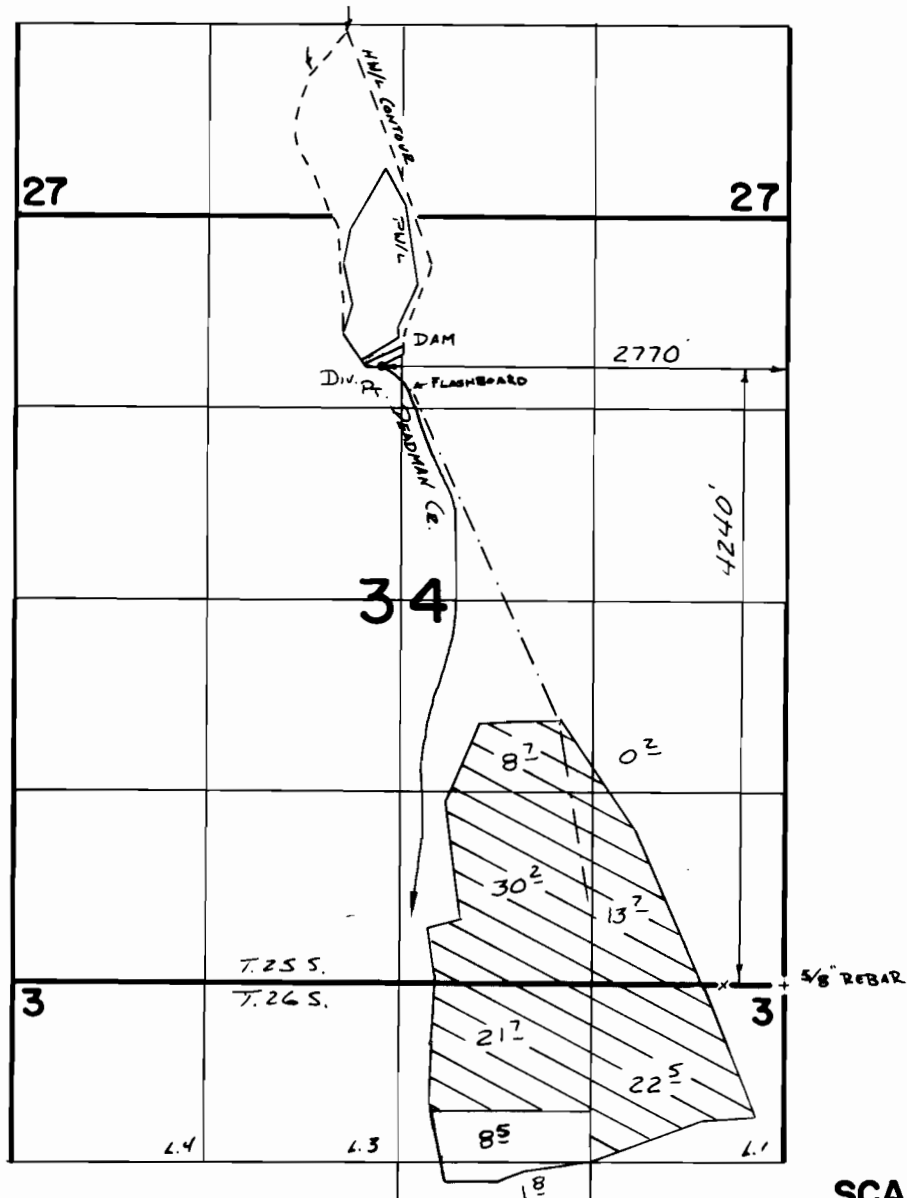

FINAL PROOF SURVEY

UNDER
R-68661
R-65326
65327

R-10787
R-8899
47934



PER. 47934

Application No. Permit No.
IN NAME OF

JERRY A. & LINDA K. MILLER...

Surveyed 5.8.1988, by T.M. WARREN.....

PTS

1-6-89 VLE