


T. 25 & 26 S., R. 35 E., W.M.

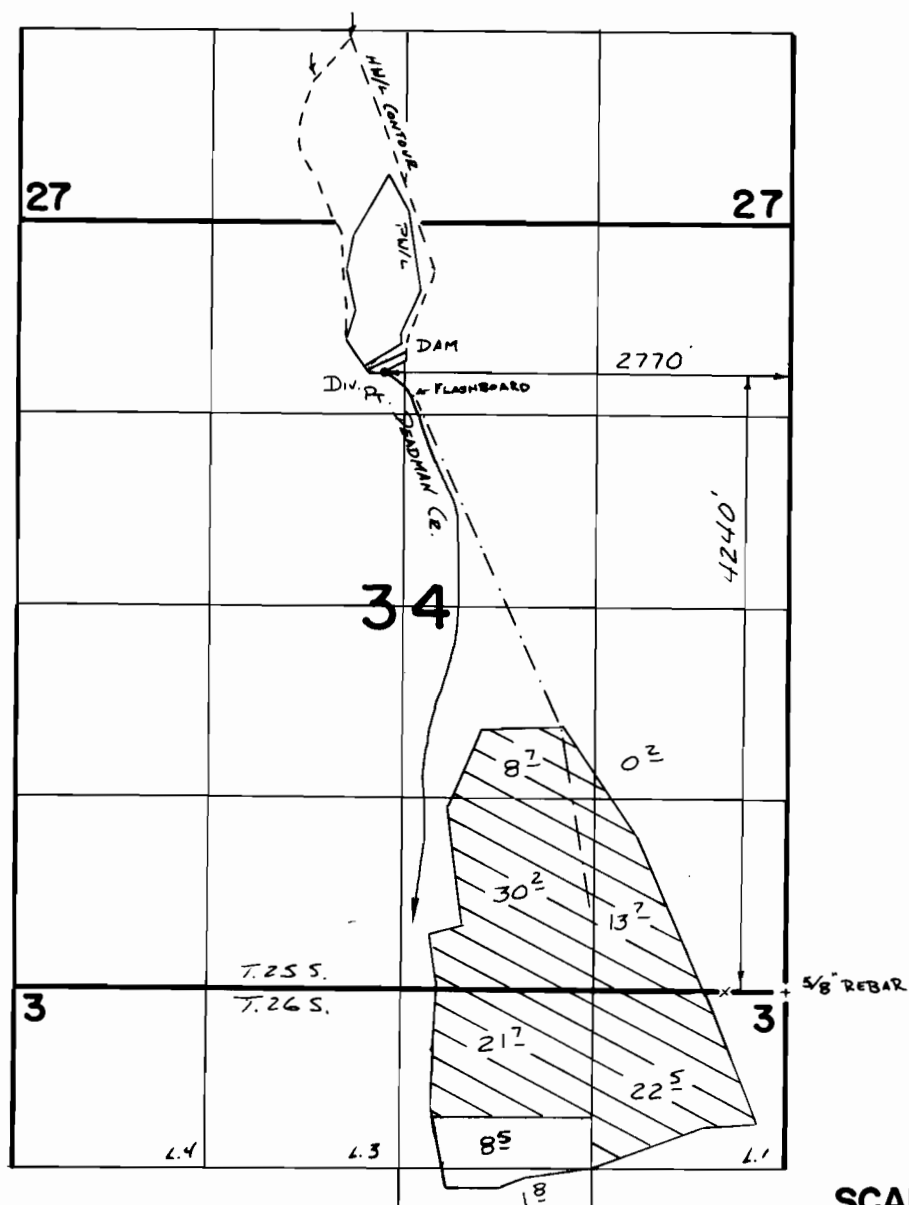

SCALE 1" = 1320'

FINAL PROOF SURVEY

UNDER
R-68661 R-10787
R-65326 R-8899
65327 47934

PER. 47934

Application No. Permit No.
IN NAME OF

JERRY A. & LINDA K. MILLER...

Surveyed 5-8-1988, by T.M. WARREN...