

Form A1-187
March 1961


UNITED STATES
DEPARTMENT OF THE INTERIOR
BUREAU OF LAND MANAGEMENT

upper
Horse Camp Res.
(1-C-293)

SECTION _____
NE SW
Sec 13
Oregon State Water Filings
TOWNSHIP 3-15, RANGE 44E, W. M. **RECEIVED**

SEP 24 1986

WATER RESOURCES DEPT.
SALEM, OREGON

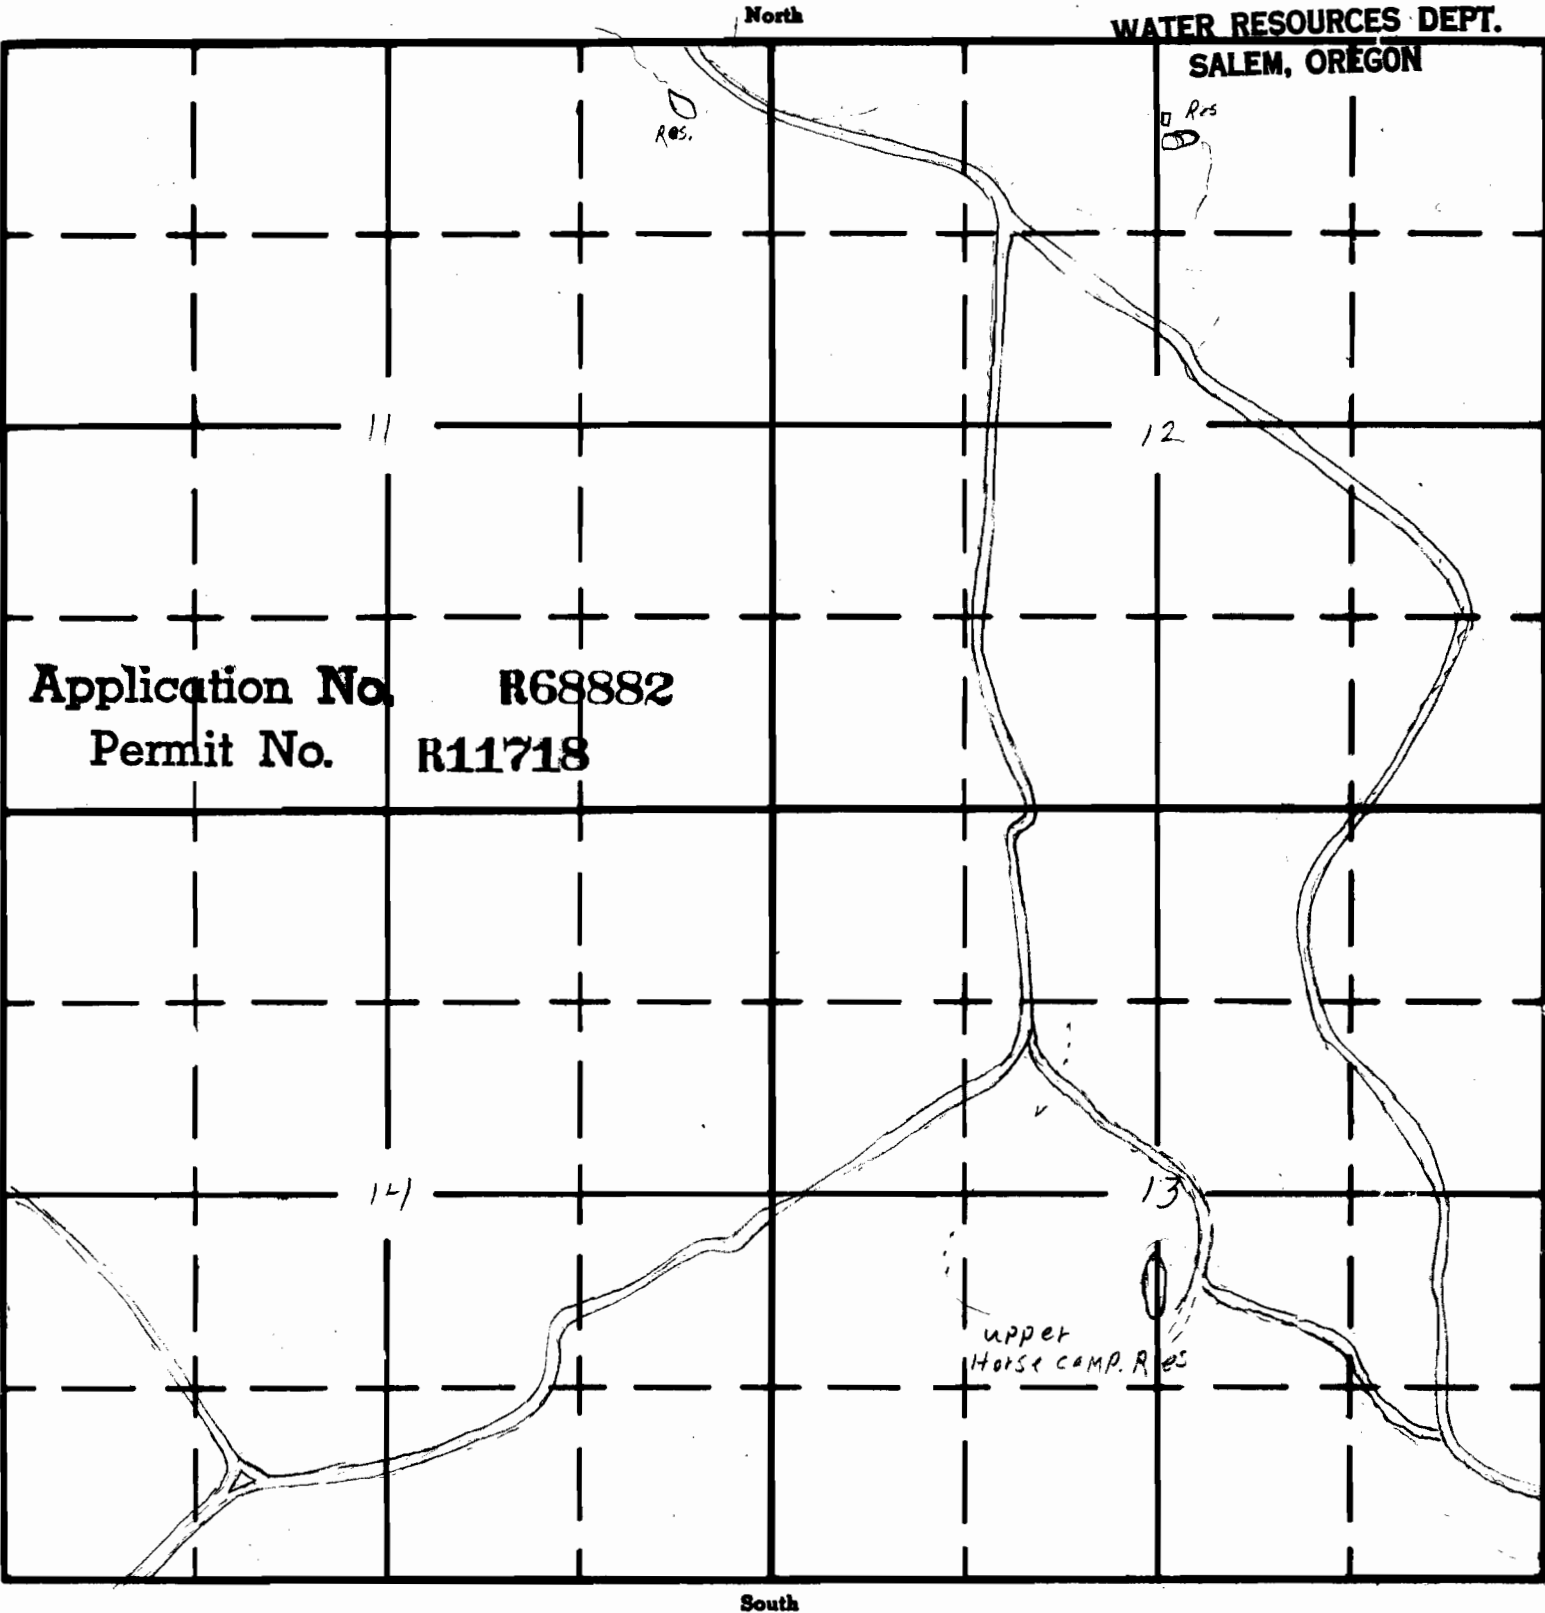

Application No. R68882
Permit No. R11718

APPLICATION No.
PERMIT No.