

UNITED STATES
DEPARTMENT OF THE INTERIOR
BUREAU OF LAND MANAGEMENT


SECTION
NE $\frac{1}{4}$ of SE $\frac{1}{4}$
Sec. 25

Oregon State Water Filings

TOWNSHIP 32S, RANGE 44E, W. M.

TODDS PIT (5044)

North

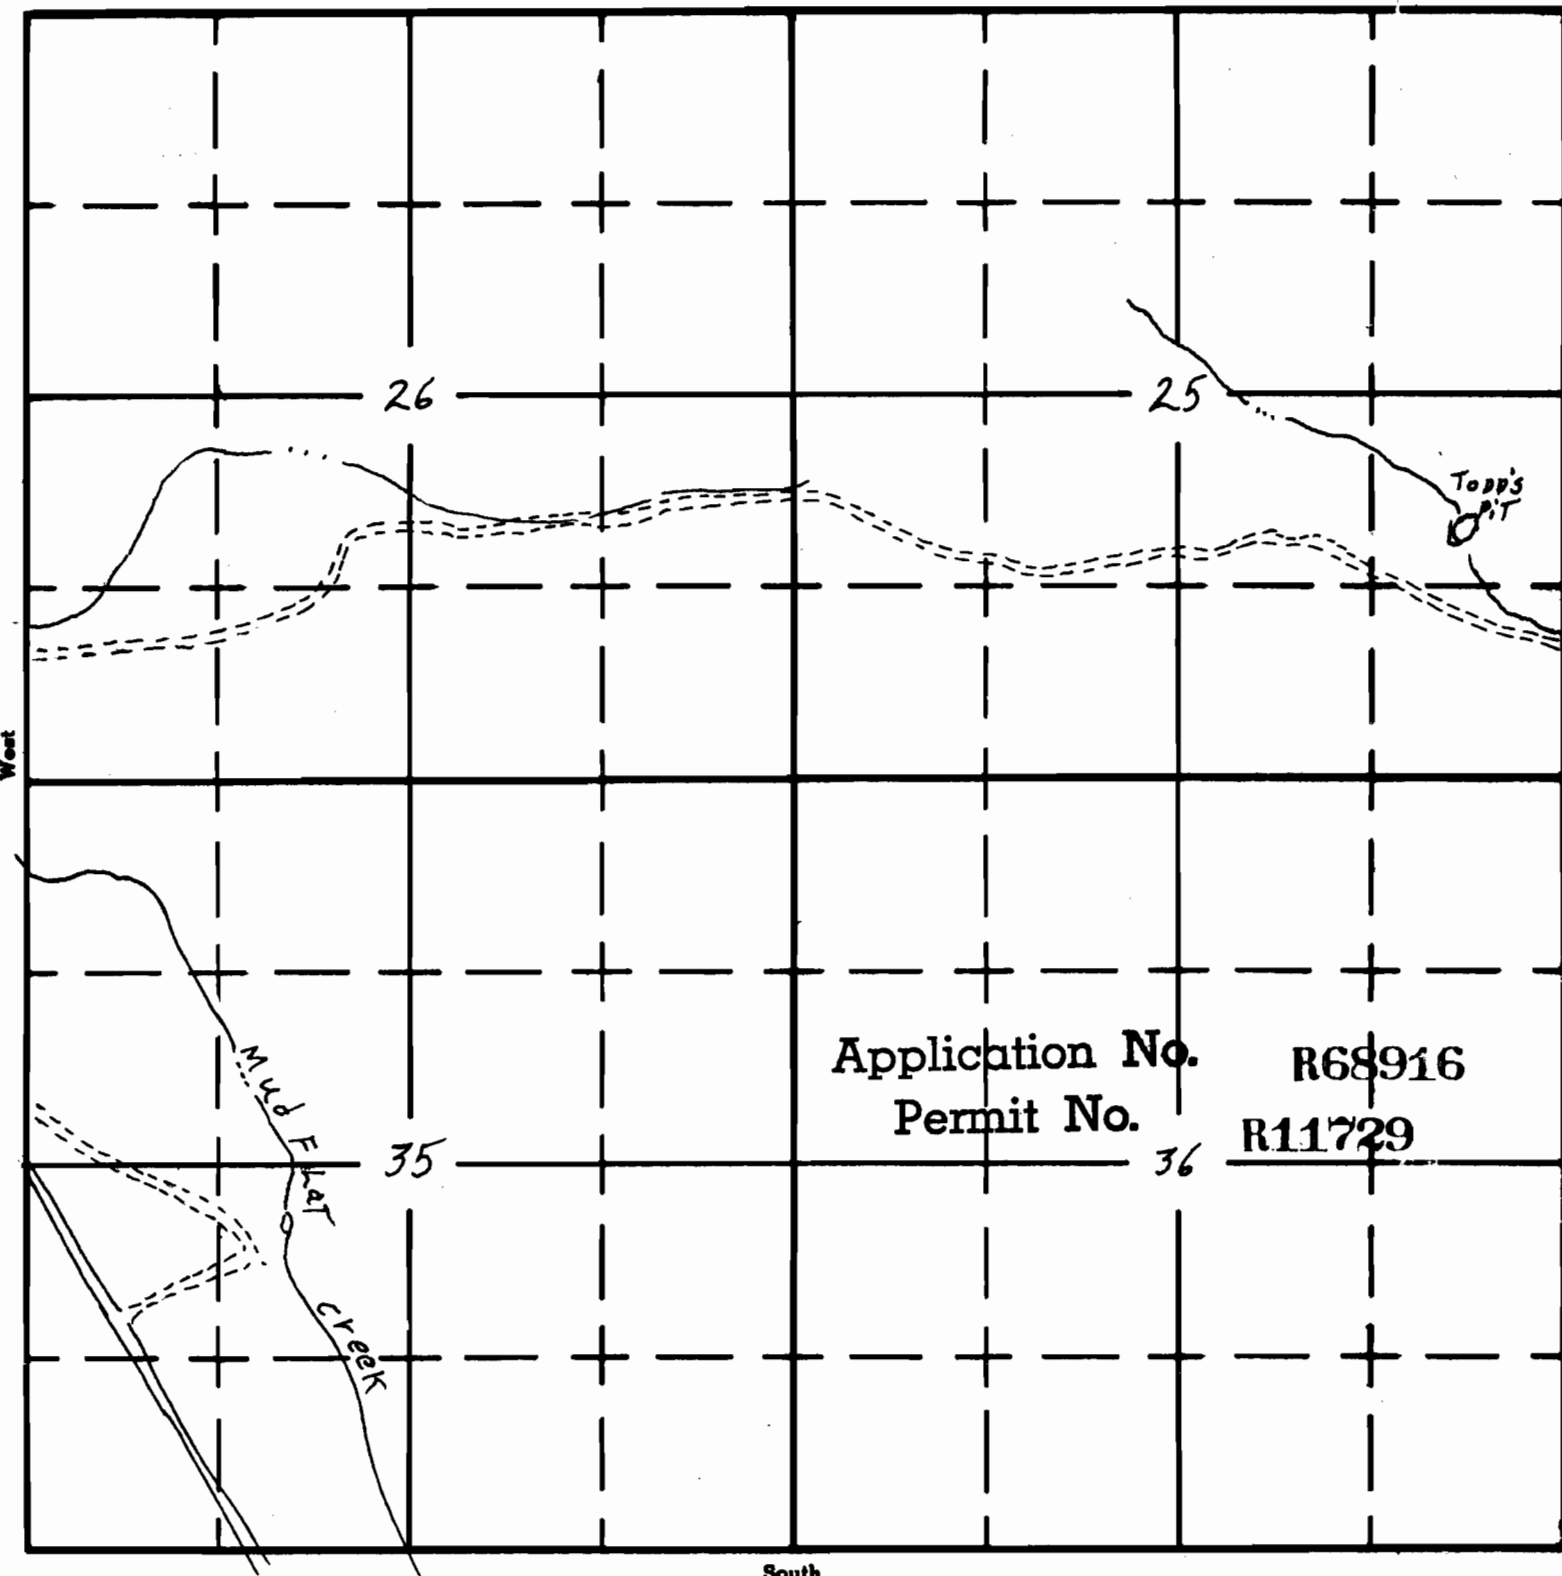

Application No. R68916
Permit No. R11729

South

APPLICATION No.
PERMIT No.