



T. 4 N., R. 39 E., W.M.

FINAL PROOF MAP
UNDER

APPLICATION NO. R-69295 PERMIT NO. R-11644

IN NAME OF
USDA, FOREST SERVICE, UMATILLA NATIONAL FOREST
SURVEYED JULY 19, 2000


GCDB POSITION

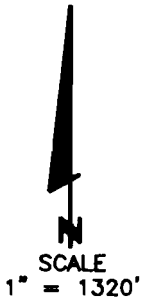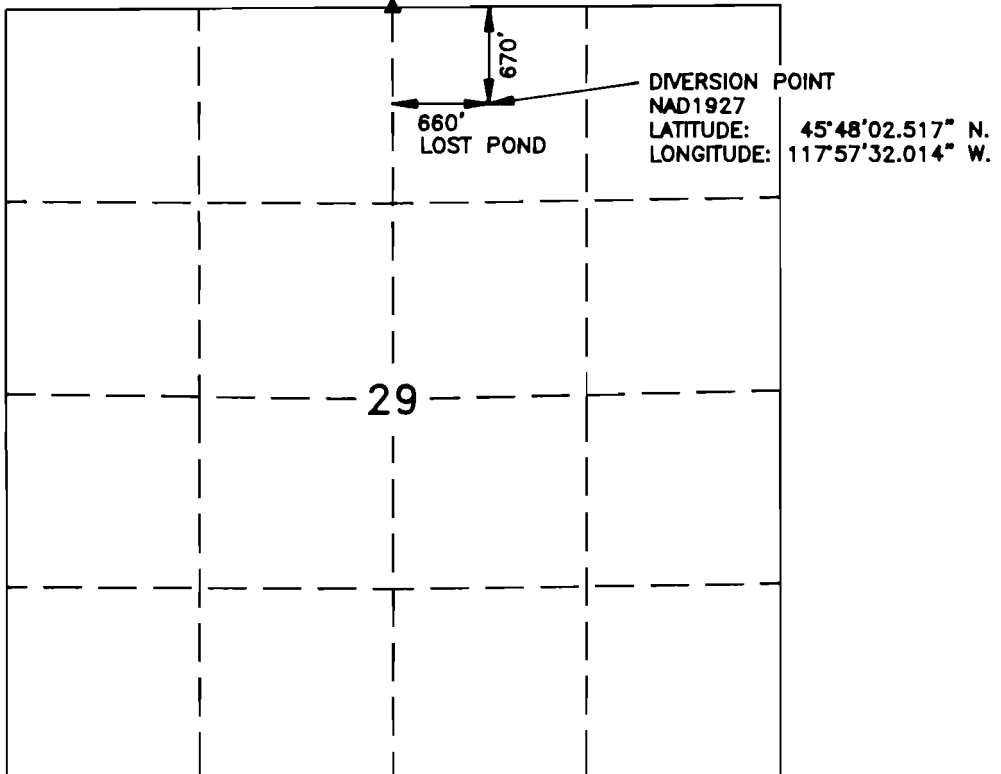

THE TIE TO THE DIVERSION POINT WAS DETERMINED BY INVERSE BETWEEN THE BUREAU OF LAND MANAGEMENT'S GCDB POSITION FOR THE 1/4 CORNER OF SECTIONS 20 AND 29 (08/12/1994 ADJUSTMENT) AND A CORRECTED GPS POSITION FOR THE DIVERSION POINT WHICH WAS OBSERVED USING A TRIMBLE PATHFINDER PROXR GPS CODE RECEIVER WITH A POSITIONAL ACCURACY OF PLUS OR MINUS 2 METERS AT THE 68% CONFIDENCE LEVEL.

THE PURPOSE OF THIS MAP IS FOR IDENTIFYING THE LOCATION OF THE WATER RIGHT ONLY. IT IS NOT INTENDED TO PROVIDE LEGAL DIMENSIONS OR LOCATION OF PROPERTY OWNERSHIP LINES.

EXECUTED BY
DAVID A. SCHLAICH, CWRE 433
UMATILLA NATIONAL FOREST
2517 SW HAILEY AVENUE
PENDLETON, OR. 97801
PHONE: (541) 278-3716

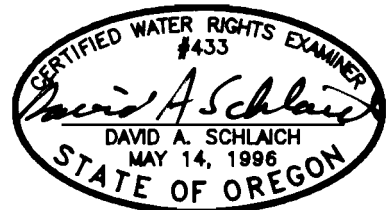

RECEIVED

RENEWAL DATE: 06/30/2002

OCT 18 2000

WATER RESOURCES DEPT
SALEM, OREGON