

T. 31 1/2 S., R. 37 E., W.M.


RECEIVED

AUG 30 1999

WATER RESOURCES DEPT.
SALEM, OREGON

DIVERSION IS 10275
FEET NORTH AND
3700 FEET WEST
OF THE SE CORNER
OF SECTION 5,
T. 32 S., R. 37 E.

DIVERSION IS 8590
FEET NORTH AND
3400 FEET WEST
OF THE SE CORNER
OF SECTION 5,
T. 32 S., R. 37 E.

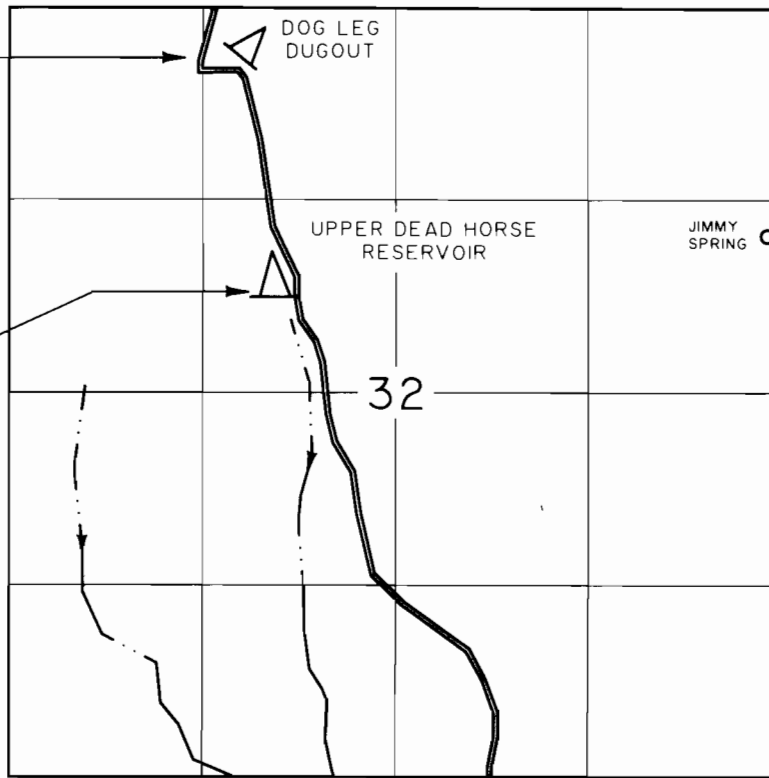

1" = 1320'


CLAIM OF BENEFICIAL USE MAP

IN NAME OF

UNITED STATES BUREAU OF LAND MANAGEMENT

APPLICATION NO. R-69339

PERMIT NO. R-11721

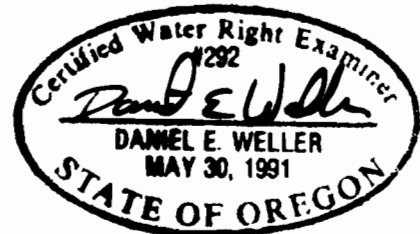

EXPIRES 6/30/00

SURVEYED: JUNE 29, 1999

THE PURPOSE OF THIS MAP IS FOR IDENTIFYING THE LOCATION OF THE WATER RIGHT ONLY AND
IS NOT INTENDED TO PROVIDE LEGAL DIMENSIONS OR LOCATION OF PROPERTY OWNERSHIP LINES

U.S. BUREAU OF LAND MANAGEMENT-OSO
BRANCH OF GEOGRAPHIC SCIENCES

DWG: DOGLEG

EXECUTED BY:
DANIEL E. WELLER, PLS, CWRE
P.O. BOX 2965
PORTLAND, OREGON 97208