


LEGEND

- SECTION LINE
- 1/4 1/4 LINE
- TAX LOT LINE
- BURIED PVC IRRIGATION PIPE
- ROAD
- CANAL
- TL00000** TAX LOT NUMBER
- $\frac{27}{34} \frac{26}{35}$ SECTION CORNER
- POA (WELL)
- IRRIGATED LANDS UNDER PERMIT G-18393
- IRRIGATED ACRES
- 1/4 1/4 SECTION
- BUILDING

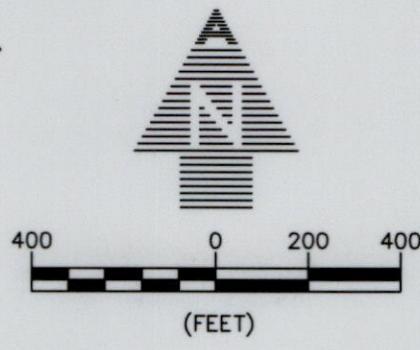

THIS MAP IS FOR THE PURPOSE OF IDENTIFYING THE LOCATION OF THE WATER RIGHT ONLY AND HAS NO INTENT TO PROVIDE DIMENSIONS OR LOCATION OF PROPERTY LINES.

WELL LOCATIONS

WELL 1 (LANE 77323): LOCATED 2122' NORTH & 403' WEST FROM THE SE CORNER OF SECTION 27, T17S, R3W, W.M. IN THE NE1/4 SE1/4, SECTION 27.

WELL 2 (LANE 77335): LOCATED 1860' NORTH & 138' WEST FROM THE SE CORNER OF SECTION 27, T17S, R3W, W.M. IN THE NE1/4 SE1/4, SECTION 27.

CERTIFIED WATER RIGHT EXAMINER
 #88332CWRE
 Daniel B. Scalas
 April 23, 2015
 STATE OF OREGON
 RENEWAL 06/30/22

AL ADKINS ENGINEERING & SURVEYING o / 541.884.4666 w / AdkinsEngineering.com
 1435 ESPLANADE AVENUE, KLAMATH FALLS, OR 97601
 SERVING S. OREGON & N. CALIFORNIA

CLAIM OF BENEFICIAL USE AND FINAL PROOF MAP FOR HOUSING AUTHORITY AND COMMUNITY SERVICES AGENCY OF LANE COUNTY, DBA HOMES FOR GOOD HOUSING AGENCY LANE COUNTY, OREGON T17S, R3W, SECS. 26 & 27, WM APPLICATION G-18750 PERMIT G-18393

RECEIVED
 APR 14 2022
 OWRD

















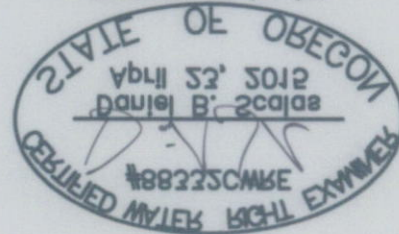







