

RECEIVED

JAN 26 2022

OWRD



Oregon Water Resources Department
725 Summer Street NE, Suite A
Salem, Oregon 97301-1266
(503) 986-0900
www.oregon.gov/owrd

Request for Assignment

If the Department determines that the application is incomplete, fees have not been paid, or the required documents are not acceptable, the application and all fees submitted will be returned to the applicant.

If for multiple rights, a separate form and fee for each right will be required.

I, PAN AMERICAN BERRY GROWERS, LLC by STEVE ERICKSON, PRESIDENT & CEO
(Name of Current Holder of Record)
6826-55TH AVE NE SALEM OR 97305 503-910-0855
(Mailing Address) (City) (State) (Zip) (Phone #)

- checkboxes for assigning interest: all my interest in and to the entire application...; all my interest in and to a portion of application...; a portion of my interest in and to the entire application...

Application # ; Permit # ; Transfer Order # GR-328T
Limited License # ; Groundwater Statement # GR-3056

as filed in the office of the Water Resources Director, to:

ESTATE OF ERNEST & LOLA ZIELINSKI TRUST, DOUG ZIELINSKI, TRUSTEE
(Name of New Owner)
5050 HAZELGREEN RD. NE, SALEM, OR 97305 (503) 932-1876
(Mailing Address) (City) (State) (Zip) (Phone #)

Note: If there are other owners of the property described in the application, permit, transfer order, limited license, or groundwater statement, you must provide a list of all other owners' names and mailing addresses and attach it to this form. Write the initials (first letters) of your first and last names at the spot indicated below.

Signature of Current Holder of Record: Steve Erickson
I hereby certify that I have notified all other owners of the property described in this application, permit, transfer order, limited license, or groundwater statement of this Request of Assignment.

X Witness my hand this 20 day of January, 20 22.
(Day) (Month) (Year)

Signature of Current Holder of Record

Failure to provide any of the required information will result in the return of your application.

This certifies assignment and record change at Oregon Water Resources Department effective 8:00 a.m. on date of receipt at Salem, Oregon.
Fee receipt # 137351
For Director by Mary F. Bjork, Program Analyst in Water Rights Division.

The completed "Request for Assignment" form must be submitted to the Department along with the recording fee of \$120.


Part. Assign - Approve
WSB 2-24-2022

RECEIVED

JAN 26 2022

OWRD

T.6S., R.2W., W.M.

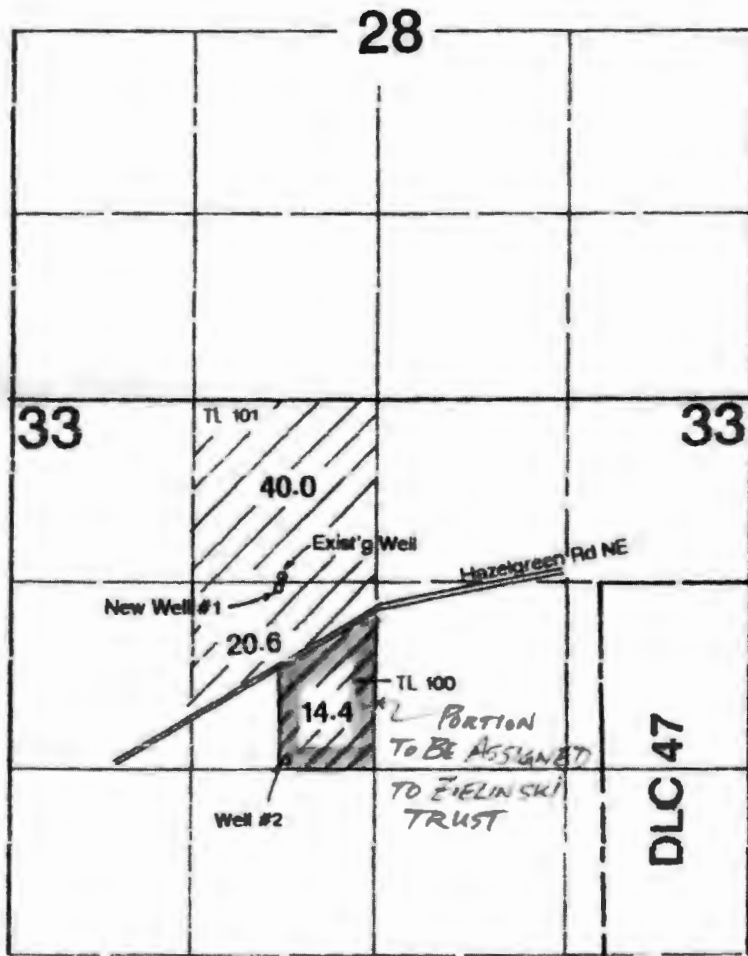

1" = 1320'



Area Involved Under Transfer

Exist'g Well is located 20' N & 650' W from the SE corner of NE1/4-NW1/4, Section 33.  
 New Well #1 (New POA) is located 30' S & 660' W from the SE corner of NE1/4-NW1/4, Section 33.  
 Well #2 (APOA) is located 20' N & 2040' E from the W1/4 corner of Section 33.

Application Map

**Pan American Berry Growers LLC.**

Transfer #:

This Map was Prepared for the Purpose of Identifying the Location of a Water Right Only and is Not Intended to Provide Legal Opinions or Location of Property Ownership Lines

**RECEIVED**

FEB 26 2015

WATER RESOURCES DEPT  
SALEM, OREGON



EXPIRES: 6.15.16

1 11990