


T. 21 S., R. 29 E., W.M.

DIVERSION IS 6990
FEET SOUTH AND
280 FEET EAST
OF THE N 1/4 COR.
OF SECTION 6.

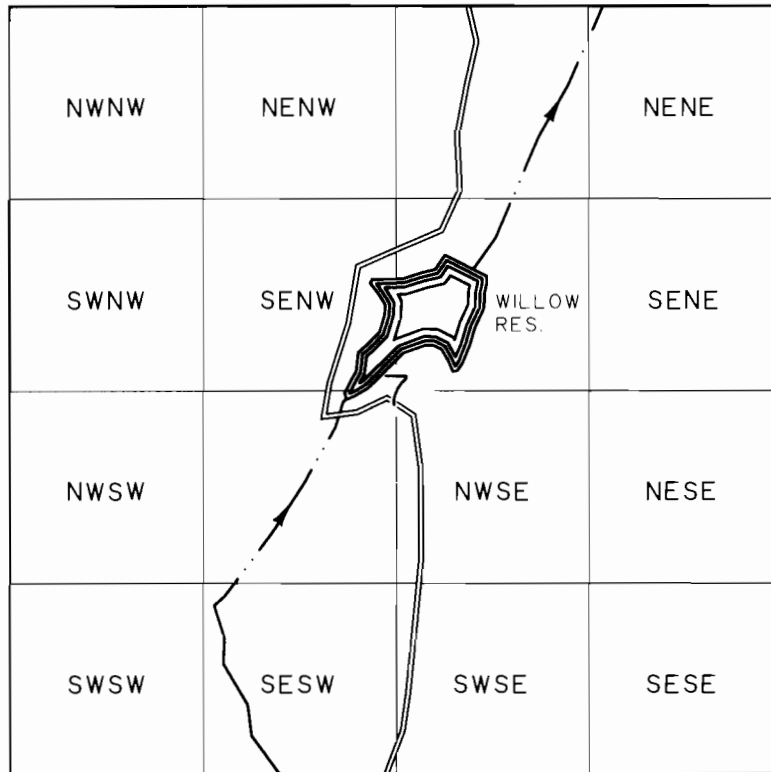

1" = 1320'

RECEIVED

AUG 30 1999

**WATER RESOURCES DEPT.
SALEM, OREGON**


CLAIM OF BENEFICIAL USE MAP

IN NAME OF

UNITED STATES BUREAU OF LAND MANAGEMENT

APPLICATION NO. R-69348

PERMIT NO. R-12115

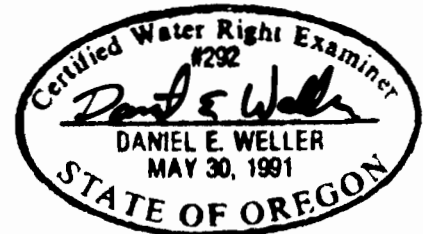

EXPIRES 6/30/00

SURVEYED: JUNE 16, 1999

THE PURPOSE OF THIS MAP IS FOR IDENTIFYING THE LOCATION OF THE WATER RIGHT ONLY AND
IS NOT INTENDED TO PROVIDE LEGAL DIMENSIONS OR LOCATION OF PROPERTY OWNERSHIP LINES

U.S. BUREAU OF LAND MANAGEMENT-OSO
BRANCH OF GEOGRAPHIC SCIENCES

DWG: WILLOW

EXECUTED BY:
DANIEL E. WELLER, PLS, CWRE
P.O. BOX 2965
PORTLAND, OREGON 97208