

T8S R40E WM

RECEIVED
OCT 16 2013

16 15

Highway 203

21 22

38.5 ac

0300


40.0 ac

5.0 ac

40.0 ac

38.5 ac

5.0 ac

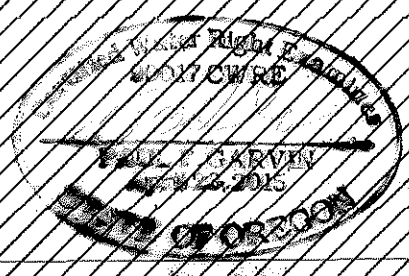

LEGEND

- Irrigated Area
- Well
- Center Pivot Pad
- 8" Mainline
- Baker County Taxlot 0300

Garvin
Hydrogeo
LLC

Claim of Beneficial Use Map
Application G-16009, Permit G-16595
Baker County, OR



Prepared on behalf of Rustin Smith
1 inch = 400 feet

Drawn by: Paul F. Garvin, R.G. C.W.R.E.
Date: 10/23/20

Notes:

Well location: 1,345' S and 1,425' E from NW Corner of Section 22.
The flowmeter is located within a 20' foot radius of the point of diversion.

This map is not intended to provide legal dimensions or locations of property ownership lines.