T. 21 S., R. 29 E., W.M.

RECEIVED
AUG 30 1999
WATER RESOURCES DEPT.
SALEM, OREGON

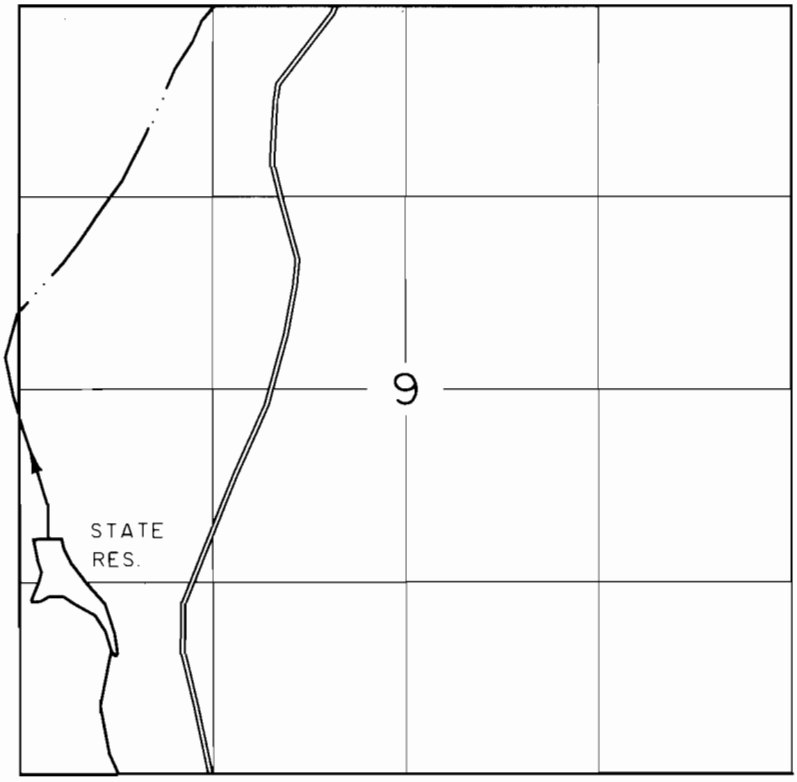

DIVERSION IS 1640 FEET NORTH AND 60 FEET EAST OF THE SW CORNER OF SECTION 9.

1" = 1320'

CLAIM OF BENEFICIAL USE MAP

IN NAME OF

UNITED STATES BUREAU OF LAND MANAGEMENT

APPLICATION NO. R-69349

PERMIT NO. R-11903

Certified Water Right Examiner
1292
DANIEL E. WELLER
MAY 30, 1991
STATE OF OREGON

EXPIRES 6/30/00

SURVEYED: JUNE 16, 1999

THE PURPOSE OF THIS MAP IS FOR IDENTIFYING THE LOCATION OF THE WATER RIGHT ONLY AND IS NOT INTENDED TO PROVIDE LEGAL DIMENSIONS OR LOCATION OF PROPERTY OWNERSHIP LINES.

U.S. BUREAU OF LAND MANAGEMENT-OSO
BRANCH OF GEOGRAPHIC SCIENCES

DWG: STATE

EXECUTED BY:
DANIEL E. WELLER, PLS, CWRE
P.O. BOX 2965
PORTLAND, OREGON 97208