


CLAIM OF BENEFICIAL USE MAP
 PERMANENT TRANSFER T-13692 (CHANGE PLACE OF USE)
 TOWNSHIP 32 SOUTH, RANGE 15 WEST, SECTIONS 16 & 21, W.M.

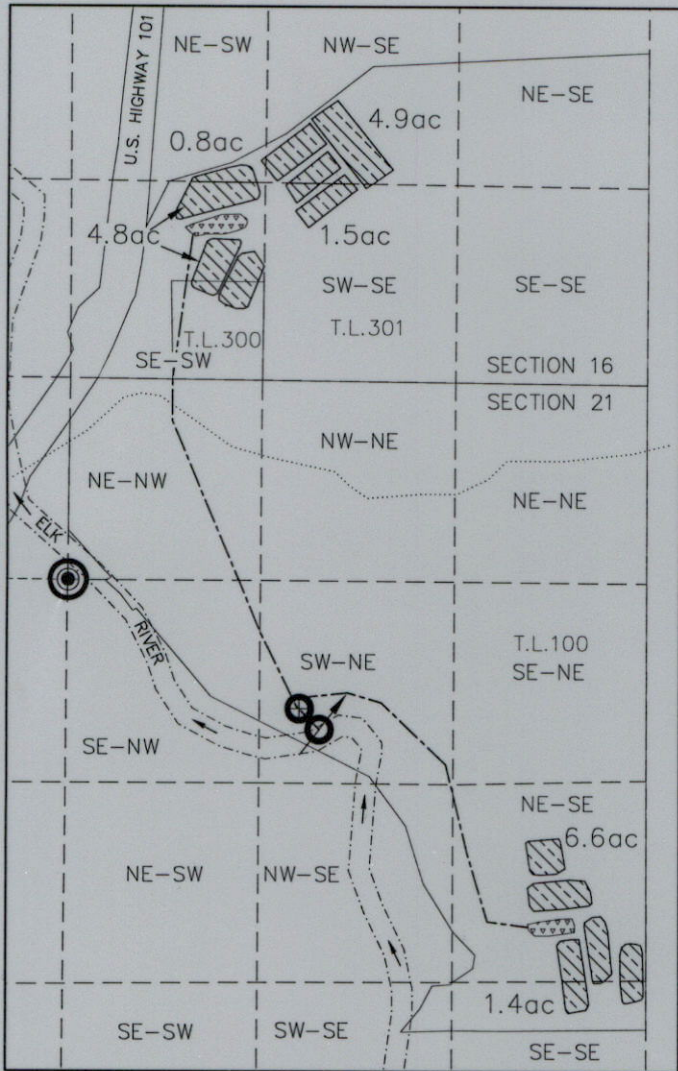

LEGEND



POINT OF BEGINNING (POB)
 SW COR. OF NE-NW Q.-Q. SEC. 21,
 T.32S., R.16W., W.M.


POINT OF DIVERSION (POD)




-POD 2: 1600 FT. E. & 960 FT. S.
 FROM POB




TOTALIZING FLOWMETER

 


INTERMITTENT UNNAMED STREAM

 

IRRIGATION MAINLINE

 

TAXLOTS

 

1/16TH SECTION LINES



BULGE




PLACE OF USE (IRRIGATION)

SECTION	Q-Q	ACRES
21	NE-SE	6.6
21	SE-SE	1.4
16	NW-SE	4.9
16	NE-SW	0.8
16	SE-SW	4.8
16	SW-SE	1.5

RECEIVED

APR 22 2022

OWRD

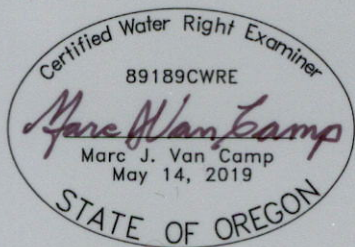

EXPIRES 06/30/2024



NORTH

1"=1320'

VCC

VAN CAMP
 CONSULTING

P.O. Box 995
 Coos Bay, OR 97420
 (541) 297-1880
 vancampconsulting@gmail.com

Prepared For:
 David Weiner
 23151 Lorentz Rd.
 Plymouth, CA 95669

Project:
 Claim of Beneficial
 Use Map T-13692

Date:
 April 8, 2022

DISCLAIMER: THIS MAP WAS PREPARED FOR THE
 PURPOSE OF IDENTIFYING THE LOCATION OF
 WATER RIGHT ONLY AND IS NOT INTENDED TO
 PROVIDE LEGAL DESCRIPTIONS OR LOCATIONS OF
 PROPERTY LINES.

















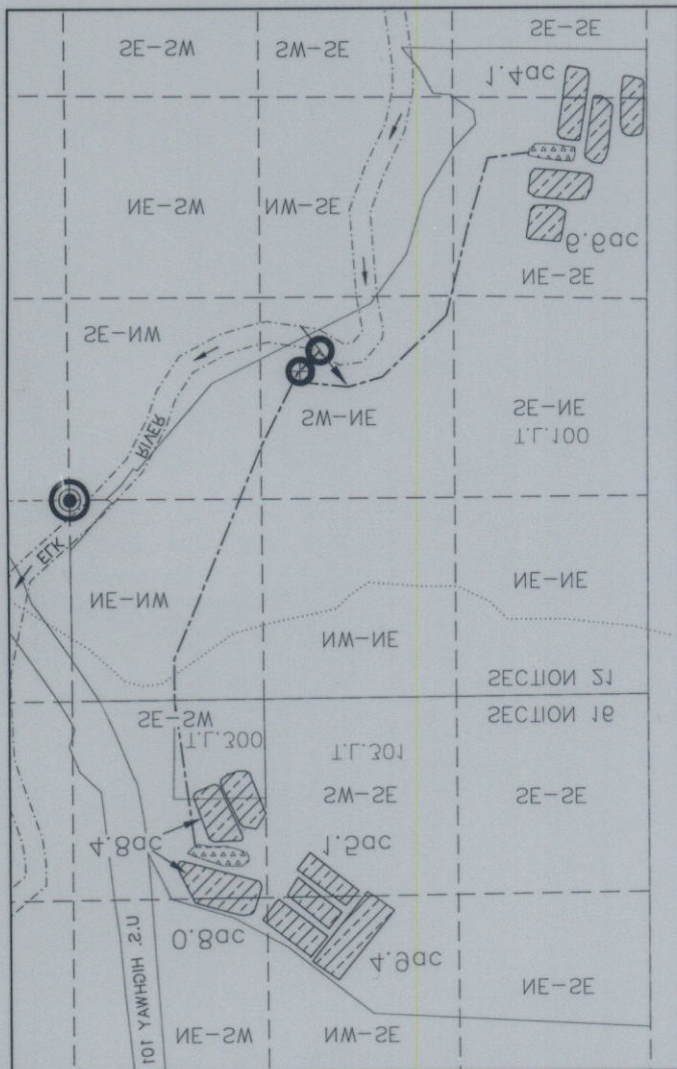




PLACE OF USE (IRRIGATION)

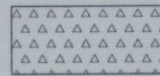












 




















 CLAIM OF BENEFICIAL USE MAP