


T. 32 S., R. 32 1/2 E., W.M.

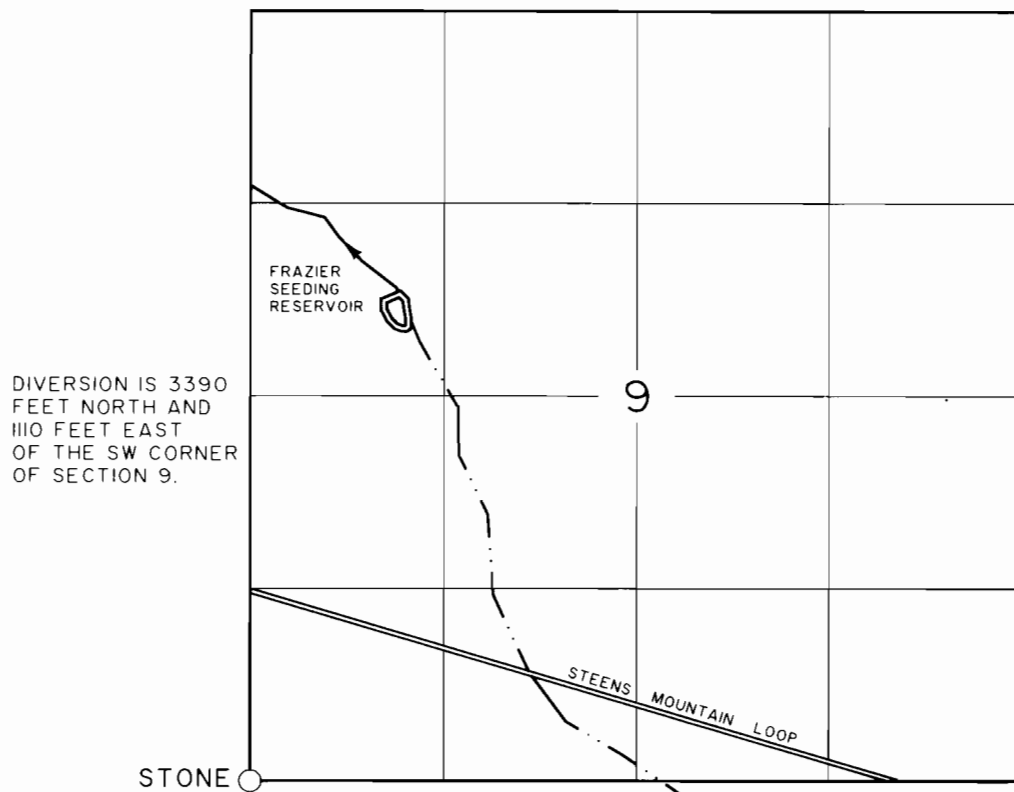

1" = 1320'

RECEIVED

AUG 30 1999

**WATER RESOURCES DIV.
BUREAU OF LAND MANAGEMENT
SALMON, OREGON**


CLAIM OF BENEFICIAL USE MAP

IN NAME OF

UNITED STATES BUREAU OF LAND MANAGEMENT

APPLICATION NO. R-69356

PERMIT NO. R-11886

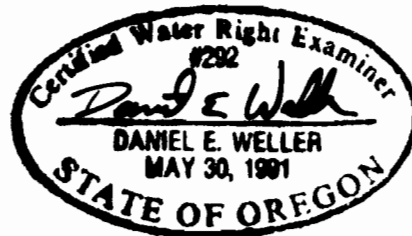

EXPIRES 6/30/00

SURVEYED: JUNE 17, 1999

THE PURPOSE OF THIS MAP IS FOR IDENTIFYING THE LOCATION OF THE WATER RIGHT ONLY AND IS NOT INTENDED TO PROVIDE LEGAL DIMENSIONS OR LOCATION OF PROPERTY OWNERSHIP LINES.

U.S. BUREAU OF LAND MANAGEMENT-OSO
BRANCH OF GEOGRAPHIC SCIENCES

DWG: FRAZIER

EXECUTED BY:
DANIEL E. WELLER, PLS, CWRE
P.O. BOX 2965
PORTLAND, OREGON 97208