

RECEIVED

APR 25 2022


OWRD

T.2 S., R.4 E., WM

RECEIVED

APR 04 2022

OWRD

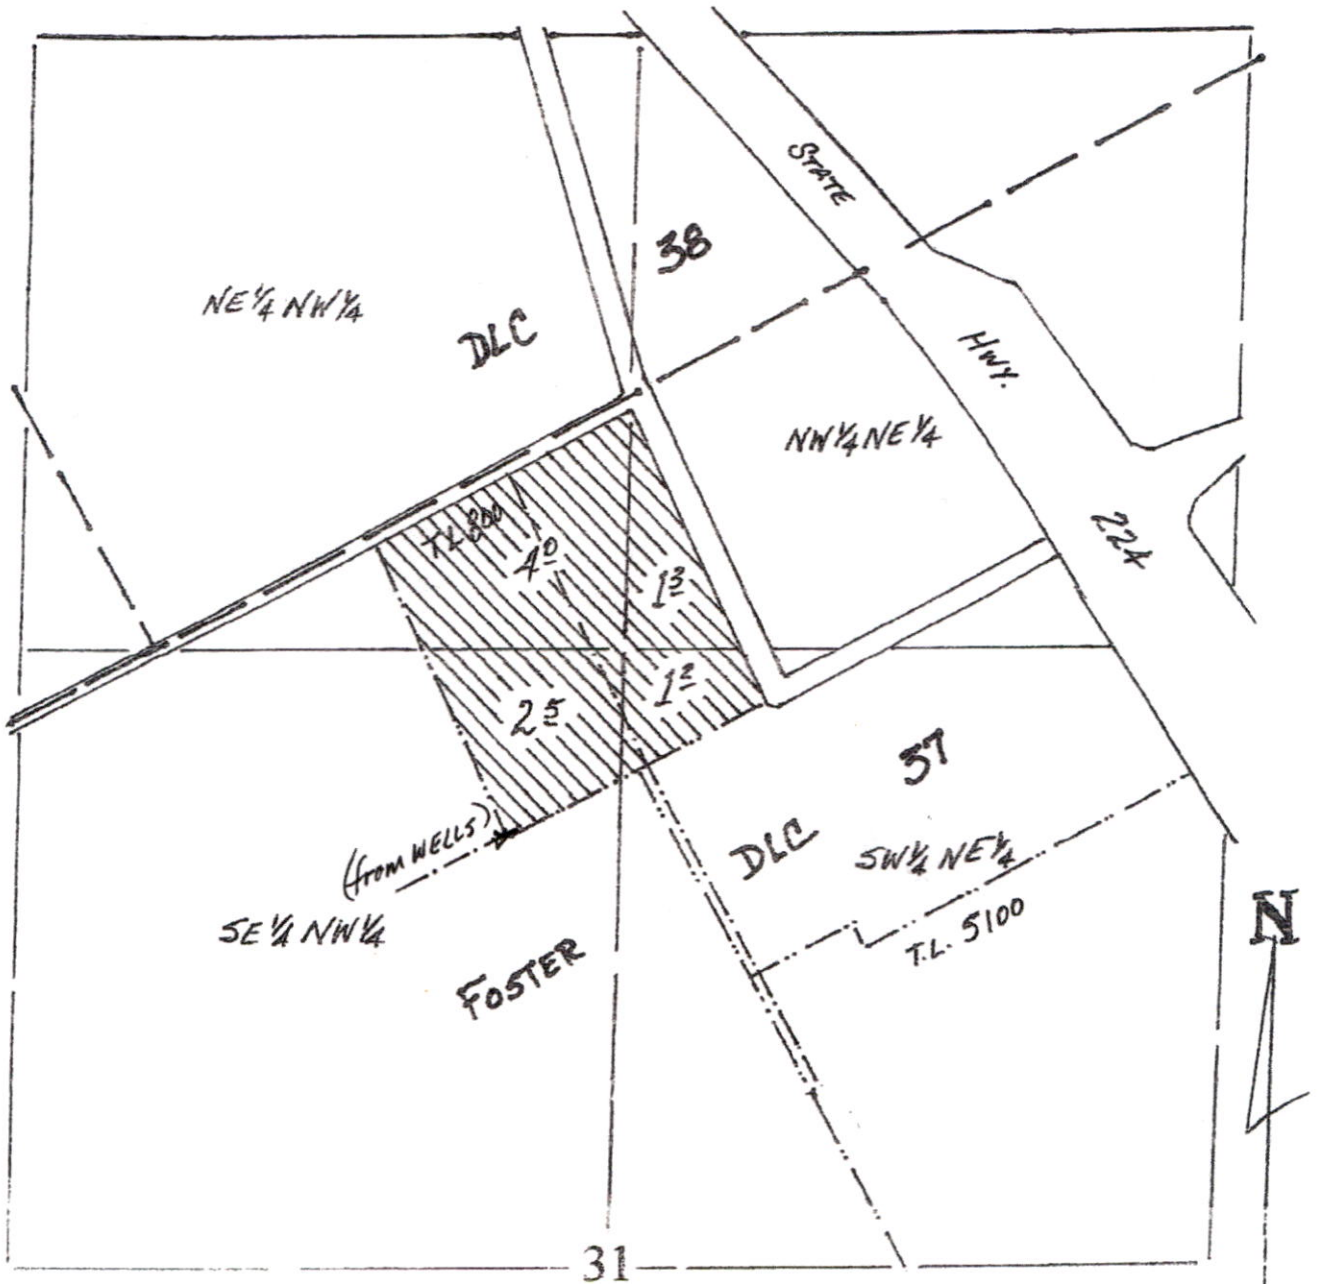

Map to Accompany Application for Permit
 In the Name of Patterson Nursery Sales, Inc.

Scale ; 1" = 400'


This map is for the purpose of identifying the location of water rights only, and is not
 Intended to provide legal dimensions or locations of property lines.

RECEIVED

APR 25 2022

OWRD

T2S, R4E, WM

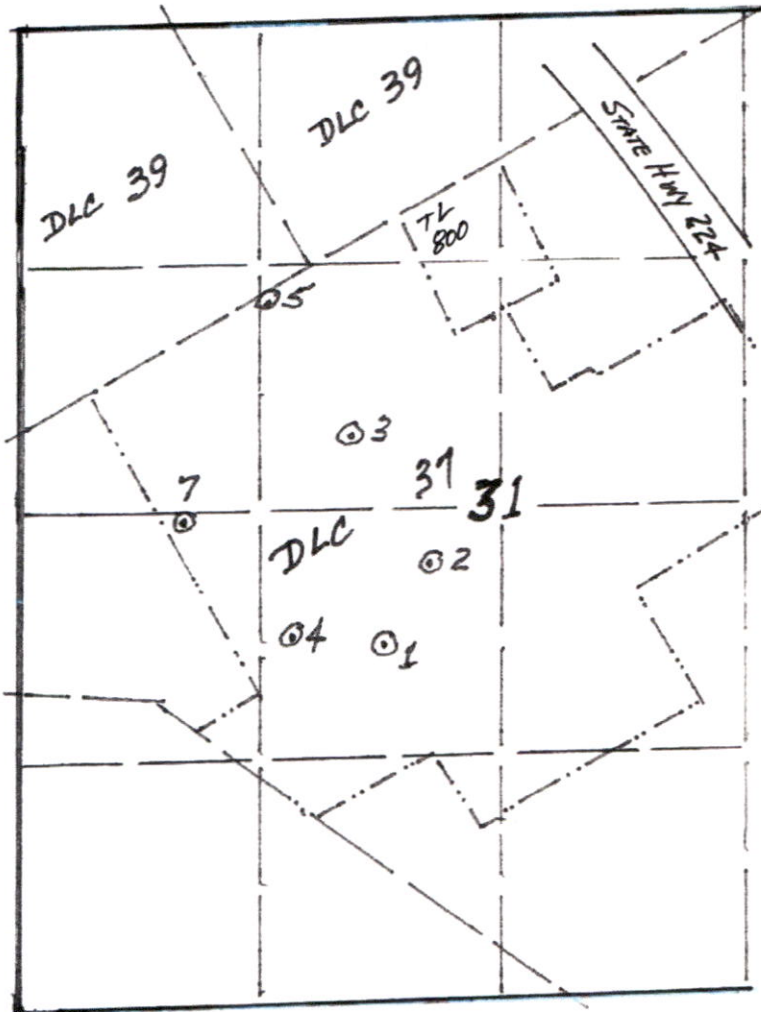

Scale ; 1" = 1,000'

RECEIVED

APR 04 2022

OWRD

Wells Located:

- #1- 2020' S & 360' E;
 - #2- 1600' S & 590' E;
 - #3- 920' S & 180' E.;
 - #4- 1980' S & 140' W;
 - #5- 190' S & 220' W;
 - #7- 1370' S & 720' W;
- All from the SW Corner DLC 39.

Application Map for
Patterson Nursery Sales