


T16S, R27E, W.M.
Grant County, Oregon


RECEIVED

MAY 02 2022

OWRD

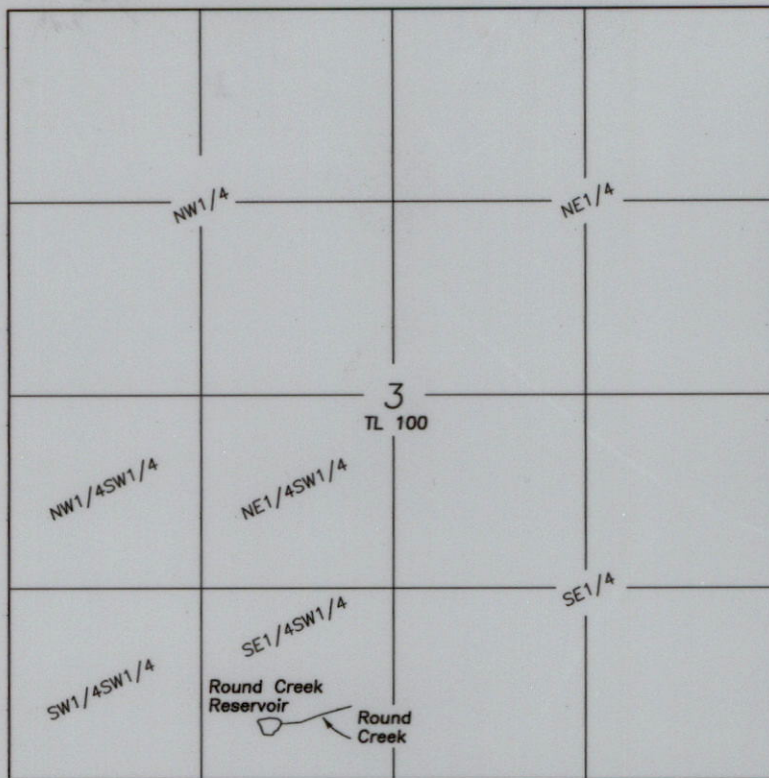

Outlet is located 330' North & 1740' East of the
SW corner of Section 3.

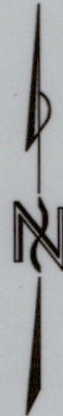

SCALE 1"=1320'

FINAL PROOF SURVEY
CLAIM OF BENEFICIAL USE
ROUND CREEK RESERVOIR

For

Bureau of Land Management

July 6, 2020

Prepared by

Cornerstone Surveying, Inc

P.O. BOX 33

JOHN DAY, OR. 97845

(541)575-1813

jwsurvey55@gmail.com

LEGEND

Application No. R-59578


Permit No. R-8011

Priority 12/21/1979

A portion of Tax Lot
16-27 TL100

NOTE: Tax Lot 100 is owned by the BLM
and is more that 17,500 acres.

NOTE: The preparation of this map
was for the purpose of identifying
the location of the proposed water
right and has no intent to provide
dimensions or location of property
ownership lines.

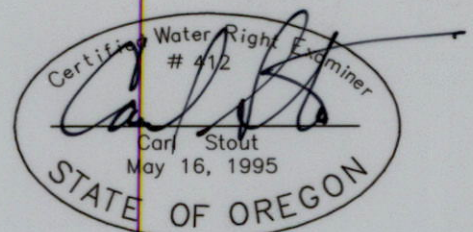

ownership lines.
 dimensions or location of property
 right and has no intent to provide
 the location of the proposed water
 was for the purpose of identifying
 NOTE: The preparation of this map



 NOTE: Tax lot 100 is owned by the BLM




P.O. BOX 33

CORNERSTONE SURVEYING, INC

Prepared by





Bureau of Land Management

For


ROUND CREEK RESERVOIR
 CLAIM OF BENEFICIAL USE
 FINAL PROOF SURVEY

LEGEND

SW corner of Section 3.
 Outlet is located 330' North & 1740' East of the

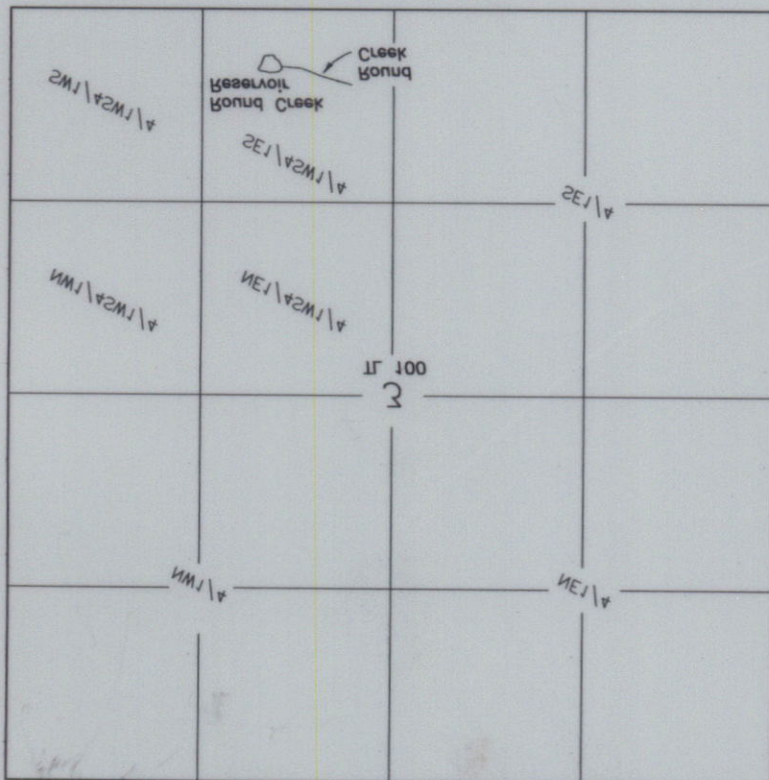

SCALE 1"=1320'

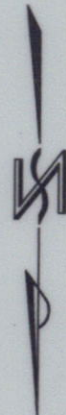




