
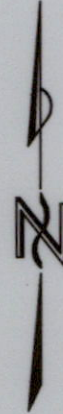


T16S, R27E, W.M.
Grant County, Oregon

RECEIVED

MAY 02 2022

OWRD

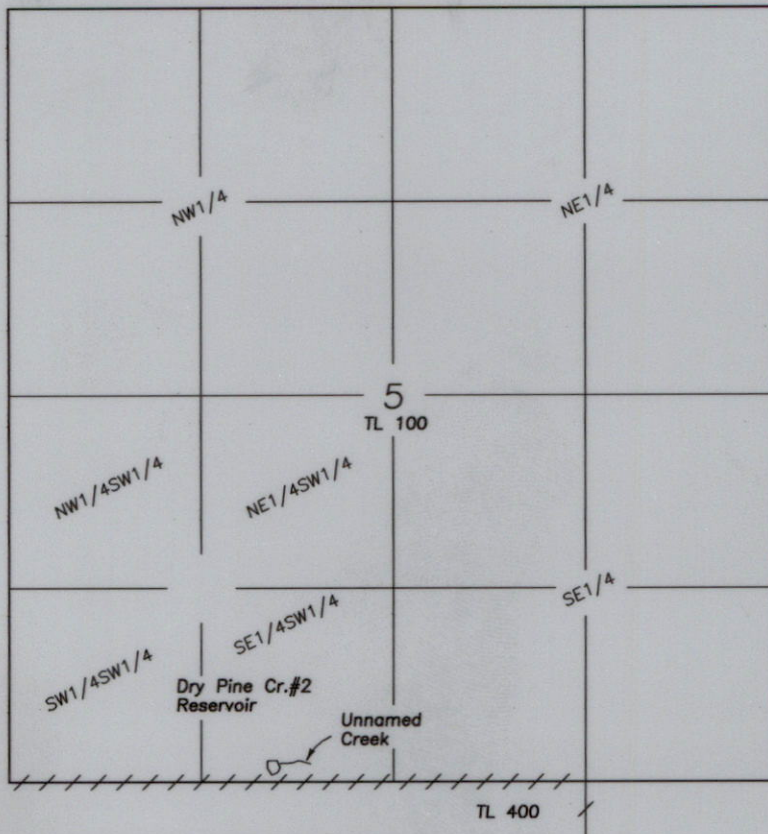

SCALE 1"=1320'

Outlet is located 50' North & 1810' East of the
SW corner of Section 5.

LEGEND

Application No. R-59577
Permit No. R-8010
Priority 12/21/1979
//// Tax Lot Boundary

A portion of Tax Lot
15-27 TL100

NOTE: Tax Lot 100 is owned by the BLM
and is more that 17,500 acres.
A portion of the tax lot boundary
is shown.

NOTE: The preparation of this map
was for the purpose of identifying
the location of the proposed water
right and has no intent to provide
dimensions or location of property
ownership lines.

FINAL PROOF SURVEY CLAIM OF BENEFICIAL USE DRY PINE CREEK #2 RESERVOIR

For

Bureau of Land Managment

July 1, 2020

Prepared by

Cornerstone Surveying, Inc

P.O. BOX 33
JOHN DAY, OR. 97845
(541)575-1813
jwsurvey55@gmail.com

