


T13S, R26E, W.M.
Grant County, Oregon

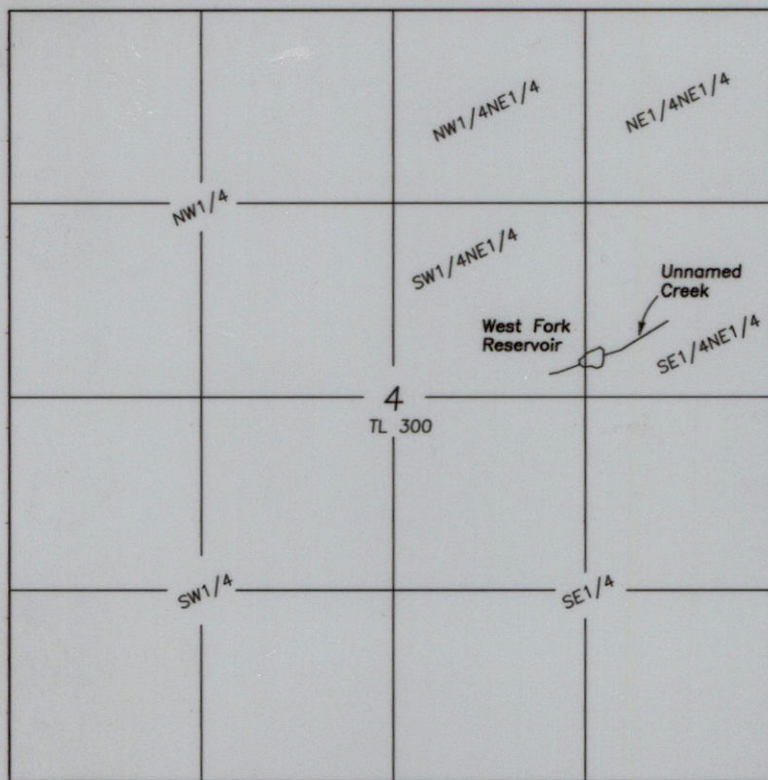

Outlet is located 2430' South & 1200' West of the
NE corner of Section 4.


LEGEND

Application No. R-59574
Permit No. R-8007
Priority 12/21/1979

Tax Lot
13-26 TL300

NOTE: Tax Lot 300 is owned by the BLM
and is more that 12,400 acres.

NOTE: The preparation of this map
was for the purpose of identifying
the location of the proposed water
right and has no intent to provide
dimensions or location of property
ownership lines.

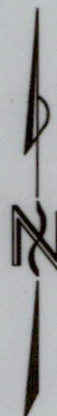

SCALE 1"=1320'

RECEIVED

MAY 02 2022

OWRD

FINAL PROOF SURVEY
CLAIM OF BENEFICAL USE
WEST FORK RESERVOIR


For

Bureau of Land Managment
July 15, 2020

Prepared by

Cornerstone Surveying, Inc

P.O. BOX 33
JOHN DAY, OR. 97845
(541)575-1813
jwsurvey55@gmail.com

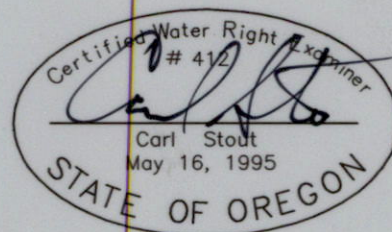

ownership lines.
 dimensions or location of property
 right and has no intent to provide
 the location of the proposed water
 was for the purpose of identifying
 NOTE: The preparation of this map





LEGEND

NE corner of Section 4.

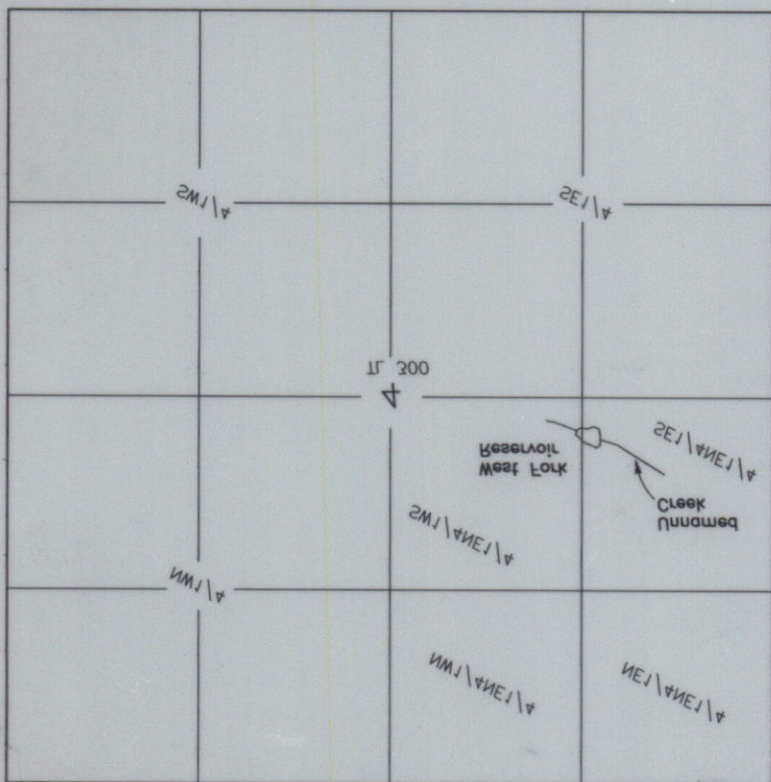







P.O. BOX 33

CORNERSTONE SURVEYING, INC

Prepared by


Bureau of Land Management

For

WEST FORK RESERVOIR
 CLAIM OF BENEFICIAL USE
 FINAL PROOF SURVEY



RECEIVED

SCALE 1"=1320'

