


T. 23 S., R. 24 E., W.M.

OREGON

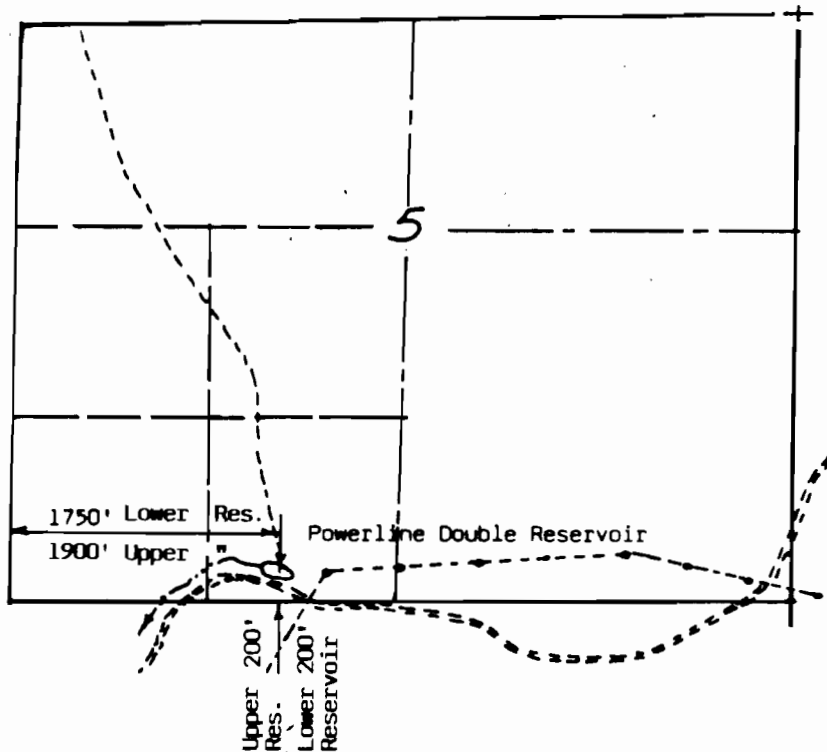

SCALE 1"=1320'

THE PURPOSE OF THIS MAP IS TO IDENTIFY THE LOCATION OF THE WATER RIGHT ONLY AND IS NOT INTENDED TO PROVIDE LEGAL DIMENSIONS OR LOCATIONS OF PROPERTY OWNERSHIP LINES

FINAL PROOF SURVEY UNDER

Application No. R-69360 Permit No. R-11177

IN NAME OF

U.S. BUREAU OF LAND MANAGEMENT

BURNS DISTRICT

SURVEYED Mar. 29 1991

