


CLAIM OF BENEFICIAL USE MAP

TO ADD POINTS OF APPROPRIATION &
PLACE OF USE FOR APPLICATION G-14970
DON AND PAT WELLS

TOWNSHIP 23 SOUTH, RANGE 33 EAST, SECTION 2, W.M.
TAX LOTS: 300

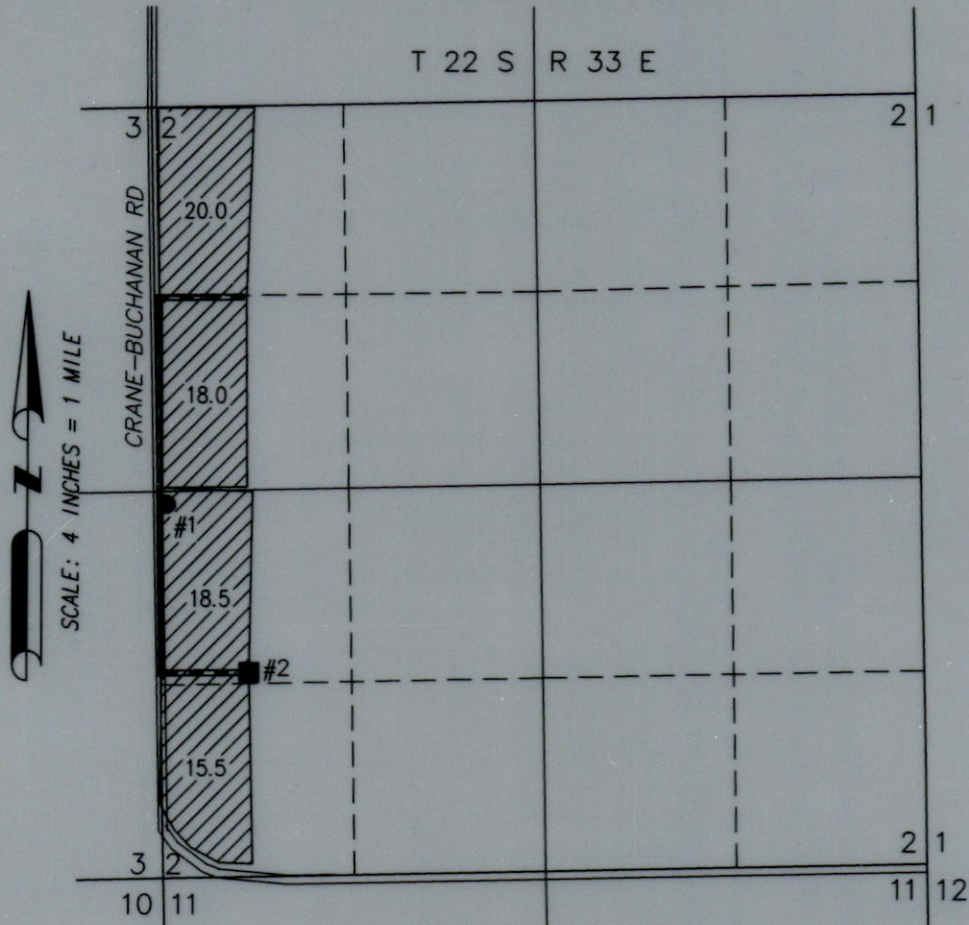


72.0 ACRES PRIMARY IRRIGATION
AUTHORIZED FROM POA #1 & POA
#2 BY PERMIT G-17848

● #1 (HARN 50195)

LOCATED IN THE NW 1/4 SW 1/4 SECTION 2, T23S
R33E, W.M. AND 2715 FEET SOUTH AND 120 FEET
EAST FROM THE NW CORNER OF SAID SECTION.
FLOW METER IS 4' WEST OF WELL.

● #2 (HARN 51456)

LOCATED IN THE NW 1/4 SW 1/4 SECTION 2, T23S
R33E, W.M. AND 3865 FEET SOUTH AND 615 FEET
EAST FROM THE NW CORNER OF SAID SECTION.
FLOW METER IS 4' WEST OF WELL.

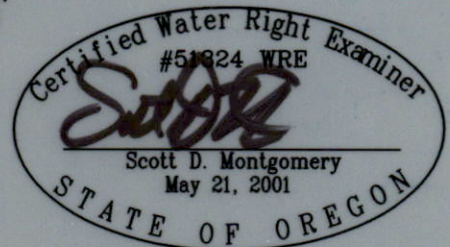

RENEWAL DATE: 12/31/2022

THIS MAP IS FOR THE PURPOSE OF LOCATING A WATER
RIGHT ONLY AND HAS NO INTENT TO PROVIDE LEGAL
DIMENSIONS OR THE LOCATION OF PROPERTY LINES.

PREPARED FOR:

DON & PAT WELLS
72023 CRANE-BUCHANAN RD
BURNS, OR 97720

PREPARED BY:



ALL POINTS ENGINEERING AND SURVEYING, INC.
P.O. BOX 767 TERREBONNE, OR 97760
(541) 548-5833 www.APEandS.com