


CLAIM OF BENEFICIAL USE MAP

TO ADD POINTS OF DIVERSION AND PLACE OF USE
FOR APPLICATION S-87600


BELL A LAND AND CATTLE, INC.

SECTIONS 2, 11, 12, 14, & 15,
TOWNSHIP 28 SOUTH, RANGE 14 EAST, W.M.
TAX LOTS: 100, 200, 1100, 1200, 1300, & 1500

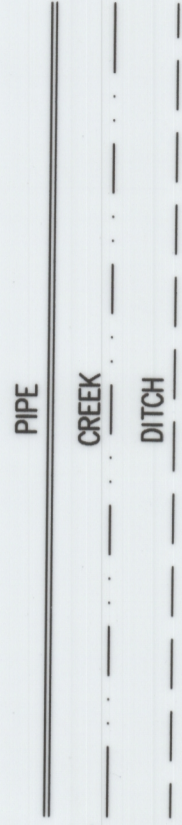


931.0 ACRES IS FROM APPLICATION S-87600, AS
SHOWN FROM PODS #1 - #6.

DETAIL OF POD FROM E. THOMPSON VALLEY RESERVOIR (PERMIT R-680):
ALL INSIDE T30S, R14E, W.M. LAKE COUNTY, OR
SCALE: 1" = 1 MILE

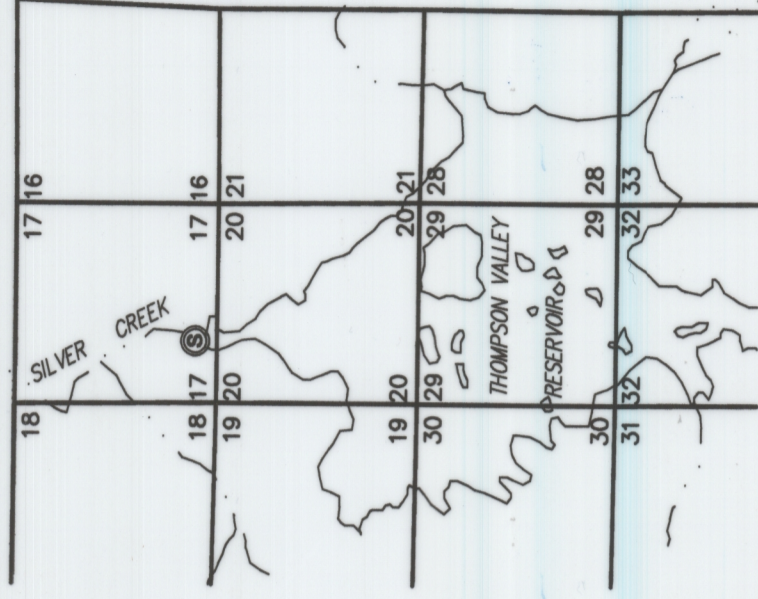

- #1 (S) POD #1 LOCATED 1070' SOUTH & 1480' EAST FROM NW CORNER SECTION 22. MEASURING DEVICE LOCATED ±50' DOWNSTREAM.
- #2 (S) POD #2 LOCATED 100' NORTH & 1560' EAST FROM SW CORNER SECTION 15. MEASURING DEVICE LOCATED ±50' DOWNSTREAM.
- #3 (S) POD #3 LOCATED 850' NORTH & 2290' EAST FROM SW CORNER SECTION 15. MEASURING DEVICE LOCATED ±20' DOWNSTREAM.
- #4 (S) POD #4 LOCATED 1380' SOUTH & 1700' WEST FROM NE CORNER SECTION 15. MEASURING DEVICE LOCATED ±10' DOWNSTREAM.
- #5 (S) POD #5 LOCATED 1750' NORTH & 1250' EAST FROM SW CORNER SECTION 11. MEASURING DEVICE LOCATED ±75' DOWNSTREAM.
- #6 (S) POD #6 LOCATED 3230' NORTH & 2030' EAST FROM SW CORNER SECTION 11. MEASURING DEVICE LOCATED ±70' DOWNSTREAM.

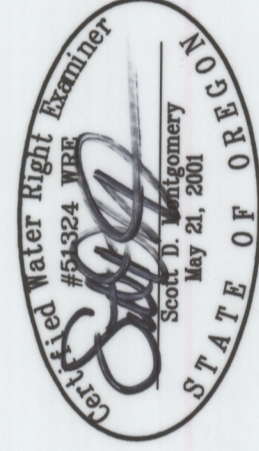

RENEWAL DATE: 12/31/2022

THIS MAP IS FOR THE PURPOSE OF
LOCATING A WATER RIGHT ONLY AND
HAS NO INTENT TO PROVIDE LEGAL
DIMENSIONS OR THE LOCATION OF
PROPERTY LINES.


COBU MAP # 2024

PREPARED BY:

ALL POINTS ENGINEERING AND SURVEYING, INC.
TERREBONNE, OR 97760
www.APEandS.com

PREPARED FOR:

BELL A LAND AND CATTLE, INC.
P.O. BOX 97
LAPINE, OR 97739

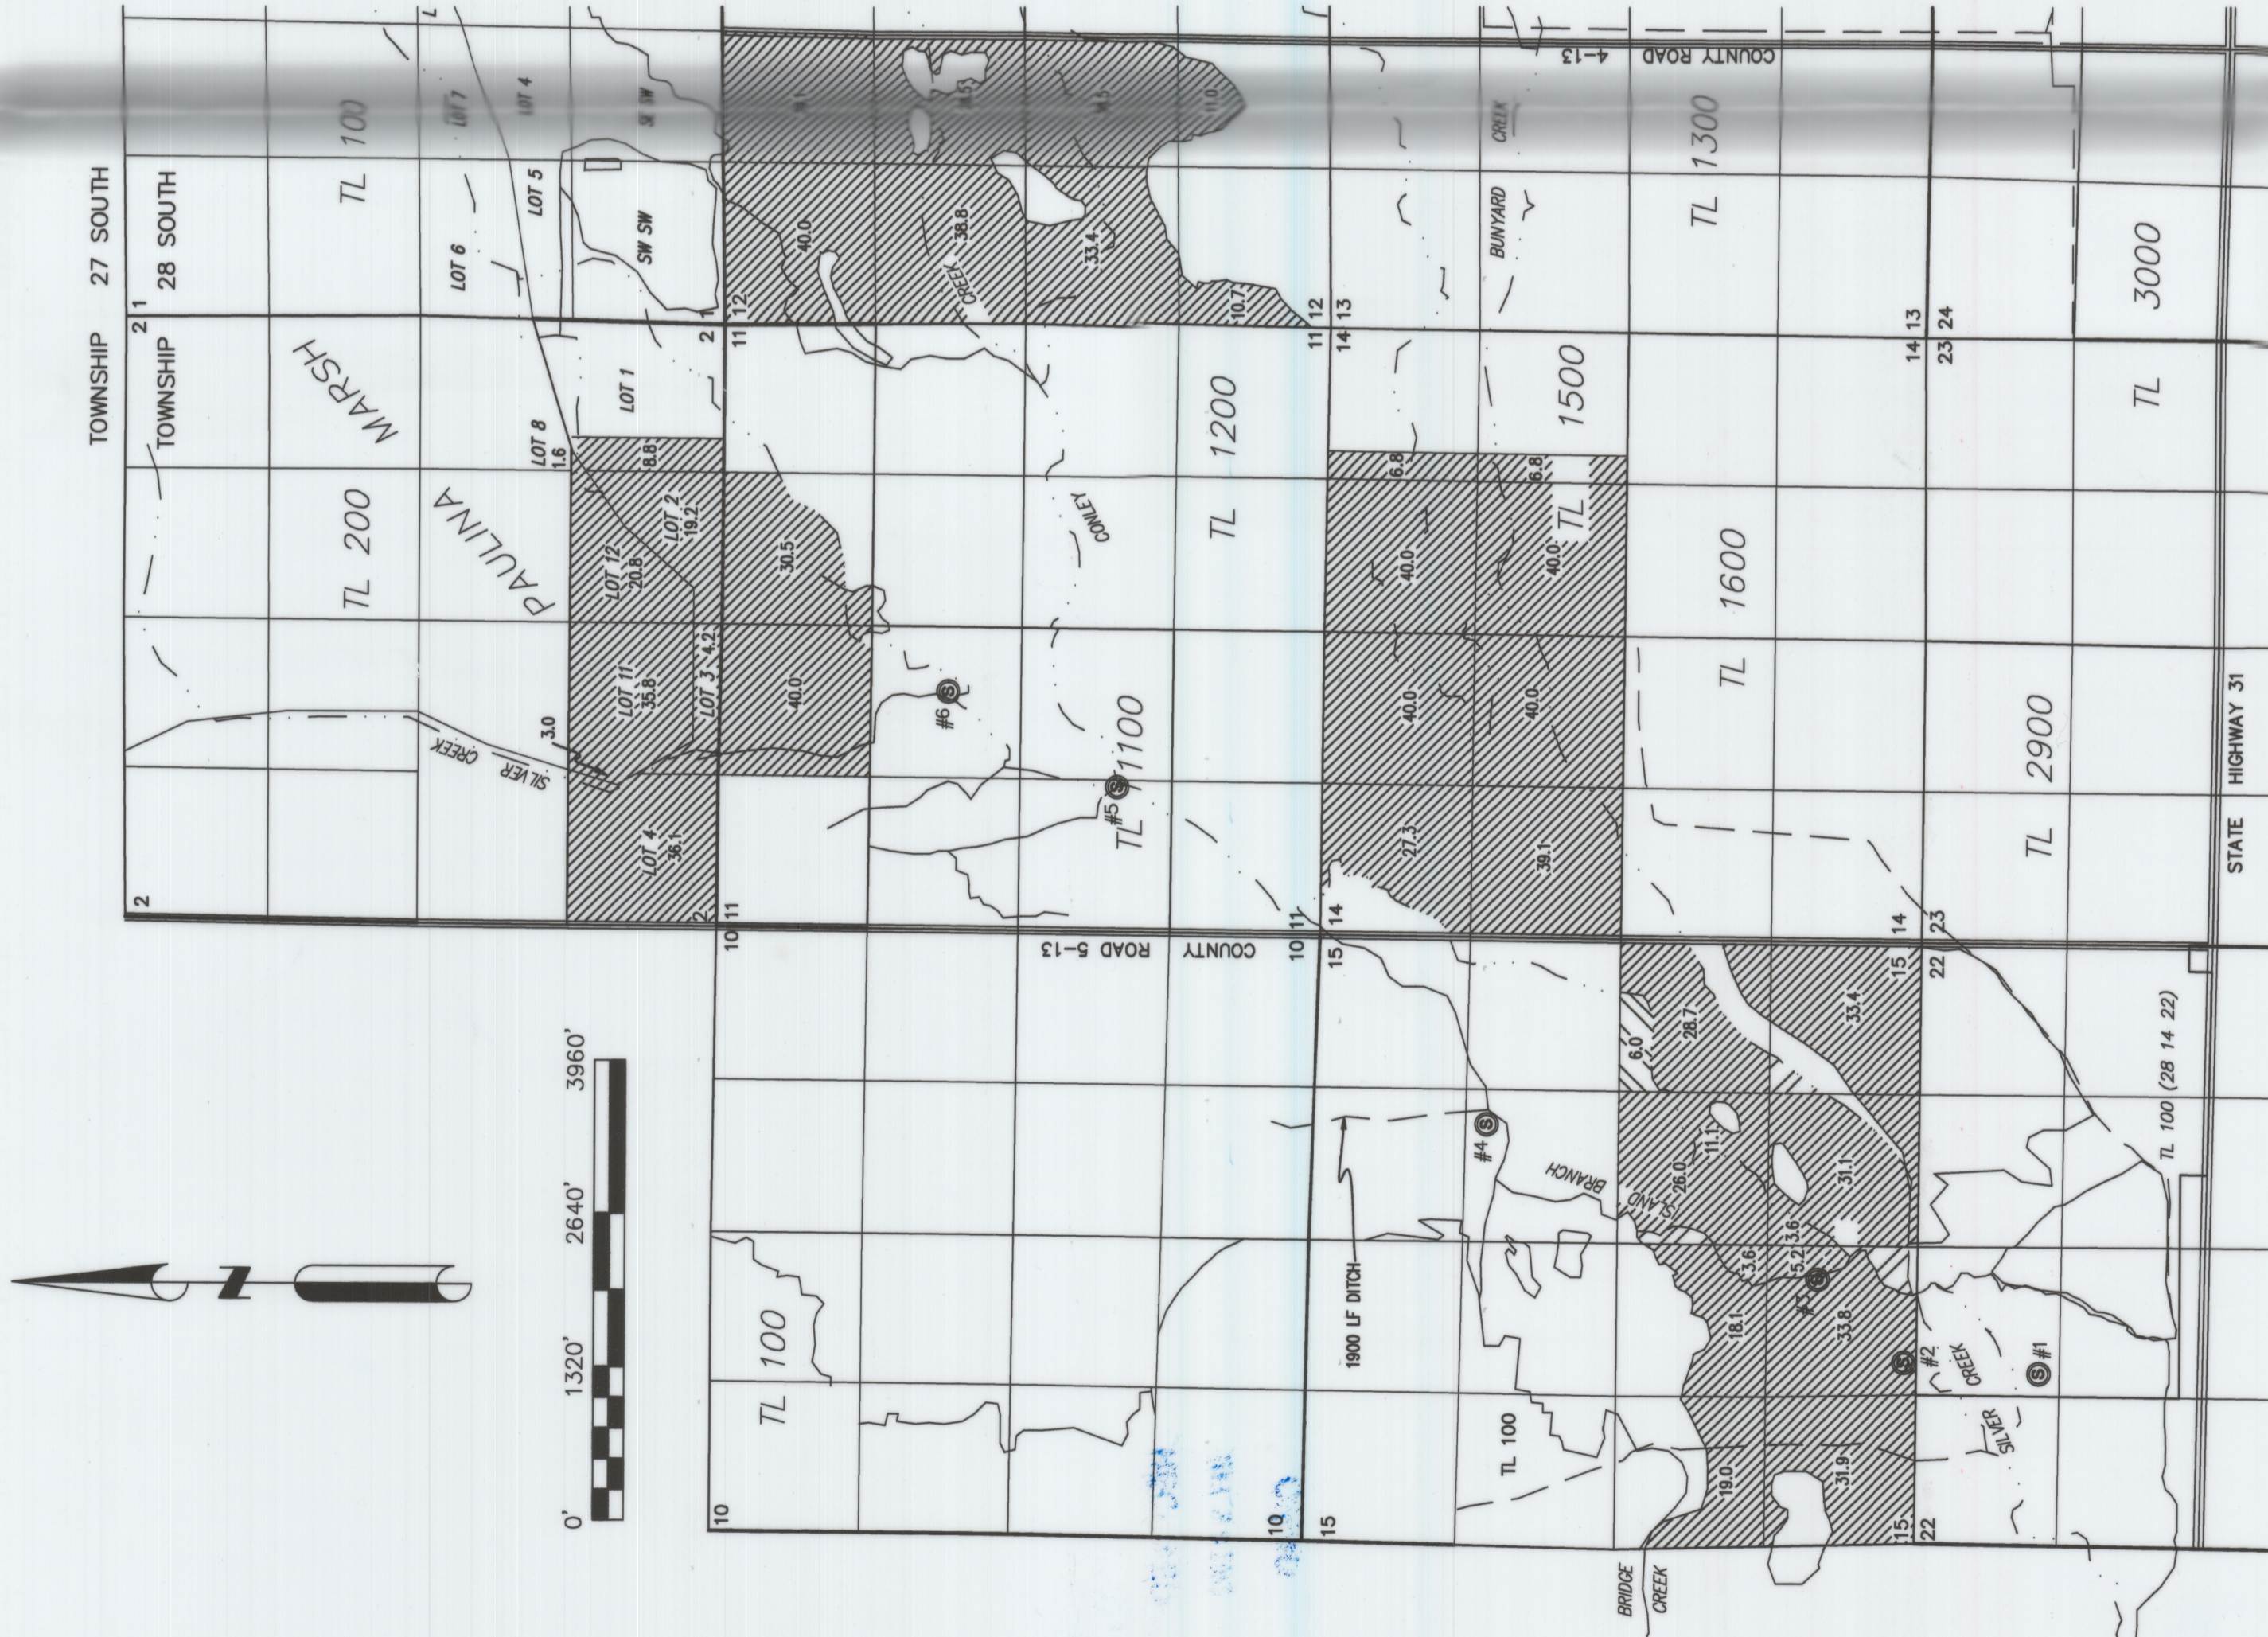

RECEIVED
MAY 30 2022

OWRD