


# CLAIM OF BENEFICIAL USE MAP

LOCATED IN SECTION 3, TAX LOT 3200, TOWNSHIP 3 SOUTH,  
RANGE 3 WEST, DLC 74, W.M., YAMHILL COUNTY, OREGON.  
WINWEY ADDRESS: 16800 NE CALKINS LANE, NEWBURG OR 97132

| APPLICATION | PERMIT  |
|-------------|---------|
| R-84698     | R-14085 |
| S-84697     | S-54142 |

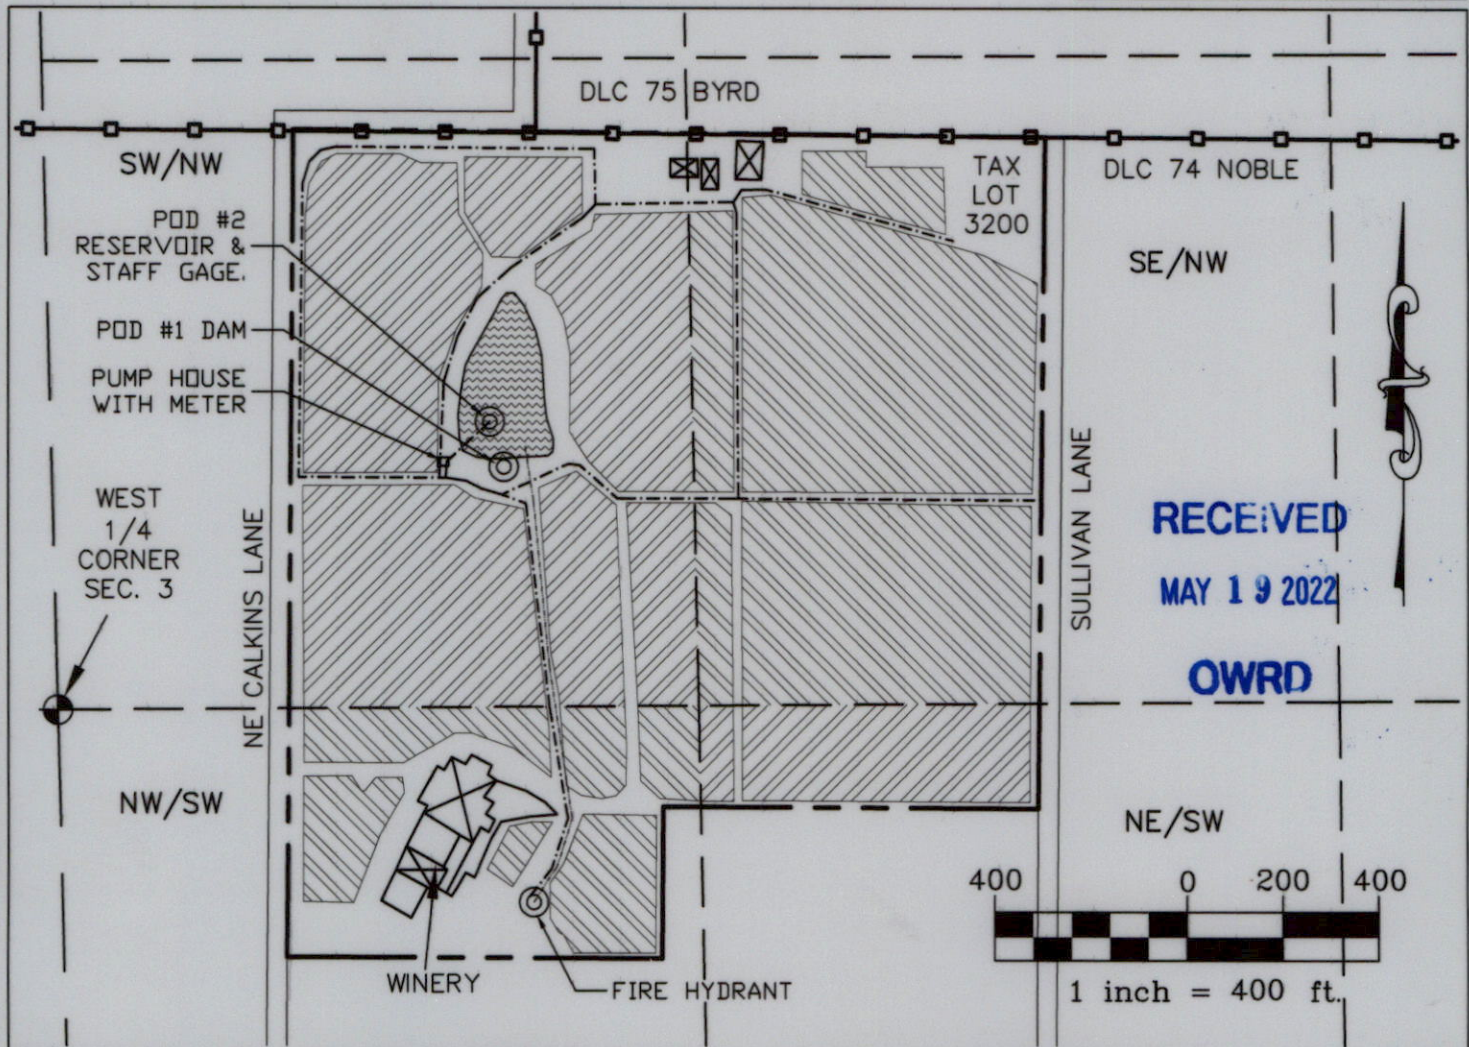

| Adelsheim Irrigation Acres |         |
|----------------------------|---------|
| by Q/Q                     | Area ac |
| SW/NW                      | 16.83   |
| SE/NW                      | 15.98   |
| NE/SW                      | 3.08    |
| NW/SW                      | 4.62    |
| Total=                     | 40.51   |

POD 1: PERMIT R-14085, DAM  
LOCATED 500' NORTH AND 920'  
EAST FROM THE WEST 1/4  
CORNER OF SECTION 3.

POD 2: PERMIT S-54142,  
RESERVOIR LOCATED 595' NORTH  
AND 900' EAST FROM THE WEST  
1/4 CORNER OF SECTION 3.

| LEGEND                |                               |
|-----------------------|-------------------------------|
| — — — 1/4-1/4 LINE    | ⊙ GOV. CORNER                 |
| — — — PROPERTY LINE   | ⊙ POD                         |
| — — — ROAD            | ⊗ BUILDING                    |
| — — — DLC LINE        | ▨ AREA OF VINEYARD IRRIGATION |
| — — — BURIED MAINLINE |                               |

The preparation of this map was for the purpose of identifying the location of the Water Right only and has no intent to provide dimensions or location of property ownership lines.


**Stuntzner**  
Engineering & Forestry, LLC

ENGINEERING \* LAND SURVEYING  
FORESTRY \* PLANNING \* WATER RIGHTS

JOB# 320-064, REVISED 4-20-22  
DRAWING : ADELSHEIM COBU MAP.DWG

2318-B PACIFIC AVENUE TEL: (503) 357-5717  
FOREST GROVE, OR 97116 FAX: (503) 357-5698

IN THE NAME OF:  
ADELSHEIM VINEYARD.

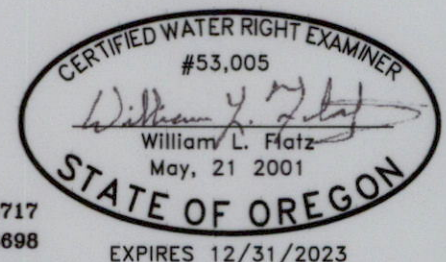

FOREST GROVE \* COOS BAY \* JUNCTION CITY