


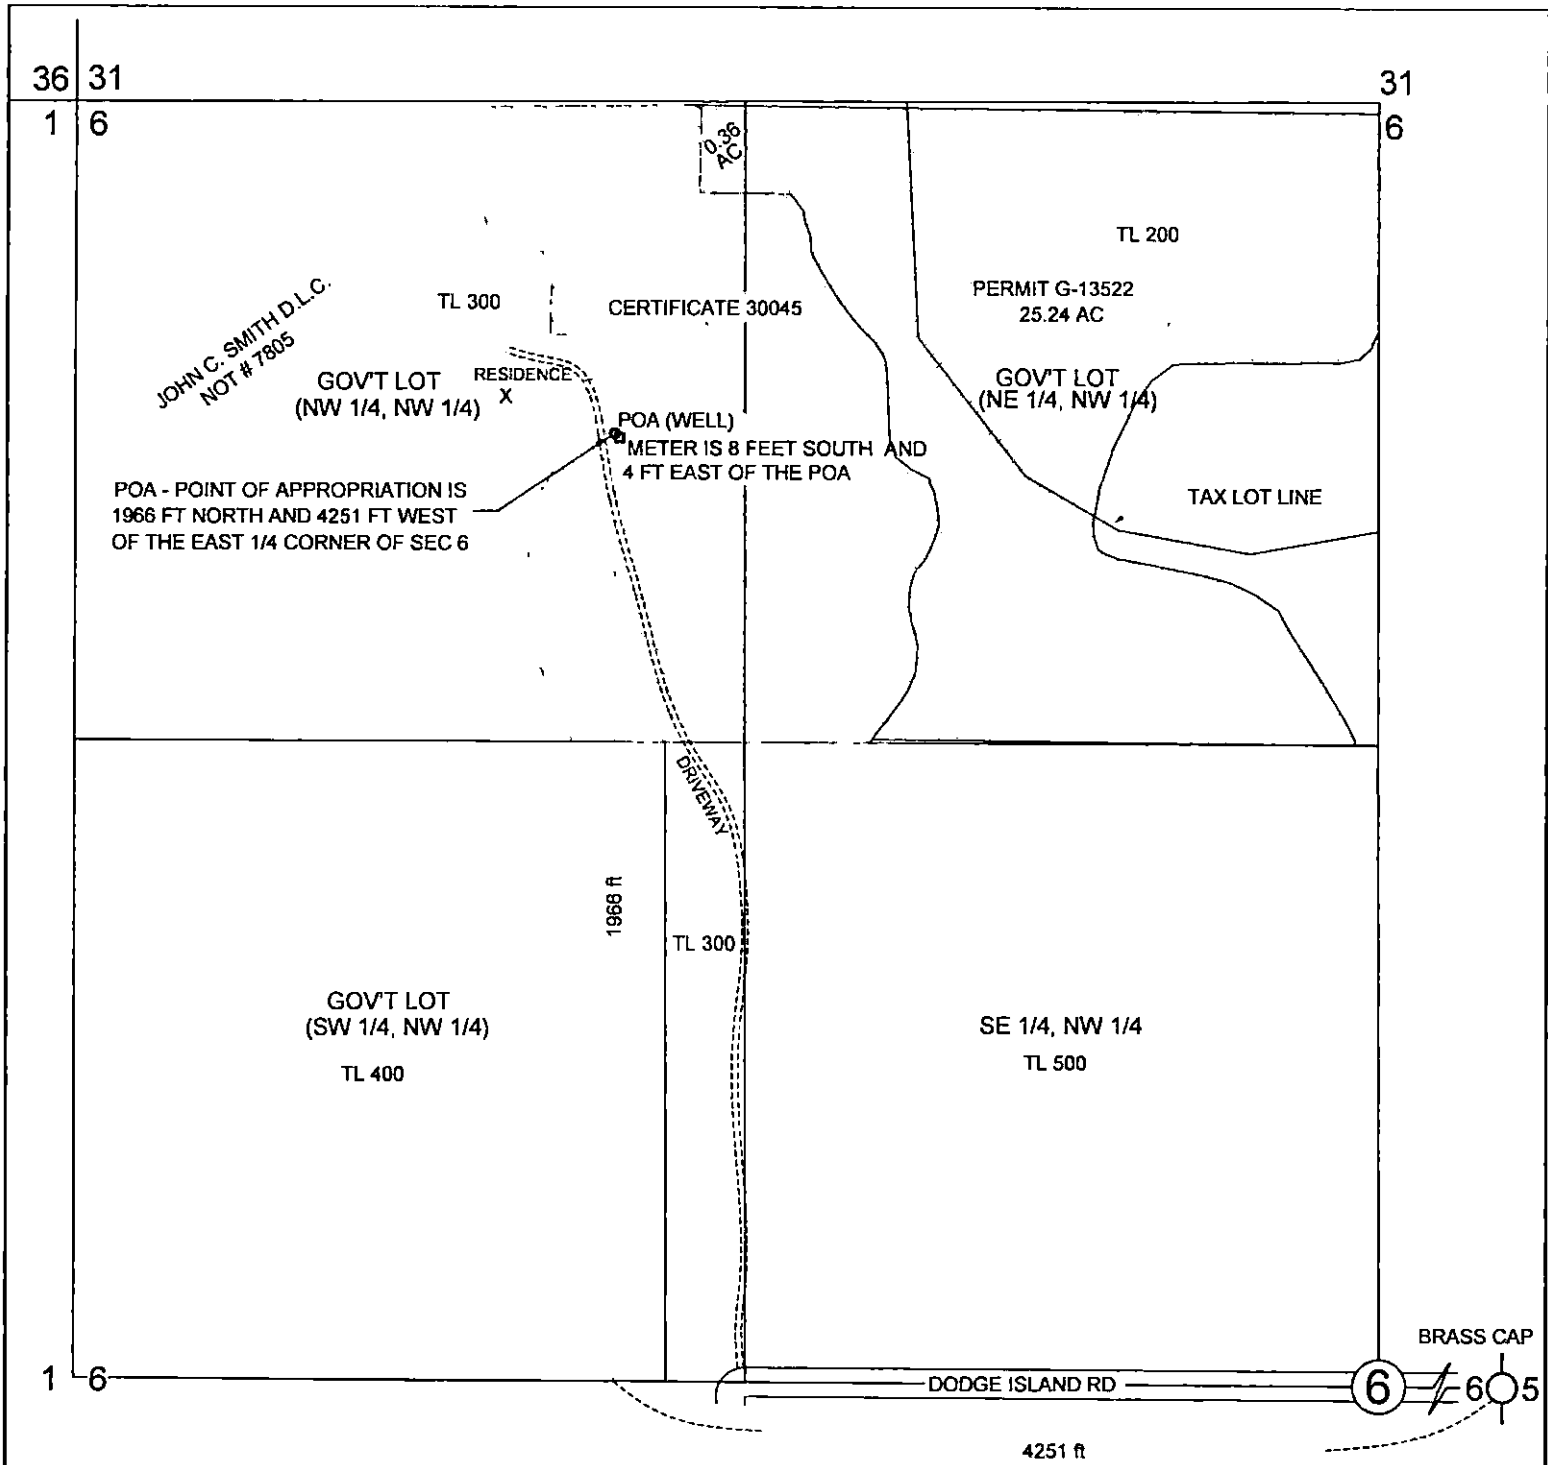

FINAL PROOF SURVEY CLAIM OF BENEFICIAL USE WATER RIGHTS MAP

DODGE SLOUGH BASIN
WITHIN THE WILLAMETTE BASIN
AND WILLAMETTE BASIN PROJECT RESERVOIR
CONSTRUCTED UNDER PERMIT R-5363

UNDER
PERMIT G-13522
APPLICATION NO. G-12806
MAP 15-04-06, TL 300 & TL 200
NE 1/4, NW 1/4, AND NW 1/4, NW 1/4 SEC. 6, T15S, R4W, W.M.
BENTON COUNTY, OREGON

FOR: PAUL B. FREEMAN
P.O. BOX 424
HARRISBURG, OREGON 97446

PREPARED BY: WOBBE & ASSOCIATES, INC.
510 KINGWOOD ST. / P.O. BOX 3093
FLORENCE, OR 97439
DATE: APRIL 01, 2022

THIS MAP IS FOR THE PURPOSE
OF IDENTIFYING THE LOCATION
OF THE WATER RIGHT ONLY.
THERE IS NO INTENT TO PROVIDE
DIMENSIONS OR LOCATION OF
PROPERTY OWNERSHIP LINES.

