




Legend

- Scotts Property
- Coos County Tax Lots
- Right of Way

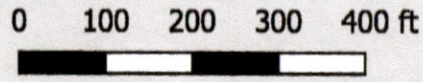

1600

RECEIVED
APR 12 2022
OWRD

T23S 14W Sec. 4
SW1/4 SW1/4

T23S 14W Sec. 4
SE1/4 SW1/4

T23S 14W Sec. 9
NW1/4 W1/4

T23S 14W Sec. 9
NE1/4 NW1/4

2999L1

0101

0200

0300

0400

0500

0600

0700

0600

0500

04000300

0700

1000

1100

1200

1300

1400

1500

1600

1700

1800

1900

2000

North Tenmile Lake

0200

0300

0400

0500

0600

0700


1800

0600



Legend

- Scotts Property
- Coos County Tax Lots
- Right of Way

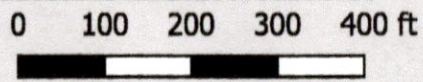

1600

RECEIVED
APR 12 2022
OWRD

T23S 14W Sec. 4
SW1/4 SW1/4

T23S 14W Sec. 4
SE1/4 SW1/4

04000300

0600

0500

0700

1400

1300

1200

1100

1000

1500

1600

1700

1800

1900

2000

2999L1

T23S 14W Sec. 9
NW1/4 W1/4

T23S 14W Sec. 9
NE1/4 NW1/4

0200

0300

0400

0500

0600

0700

0101

North Tenmile Lake

0200

0300


0400

0500

0600

1800


0600

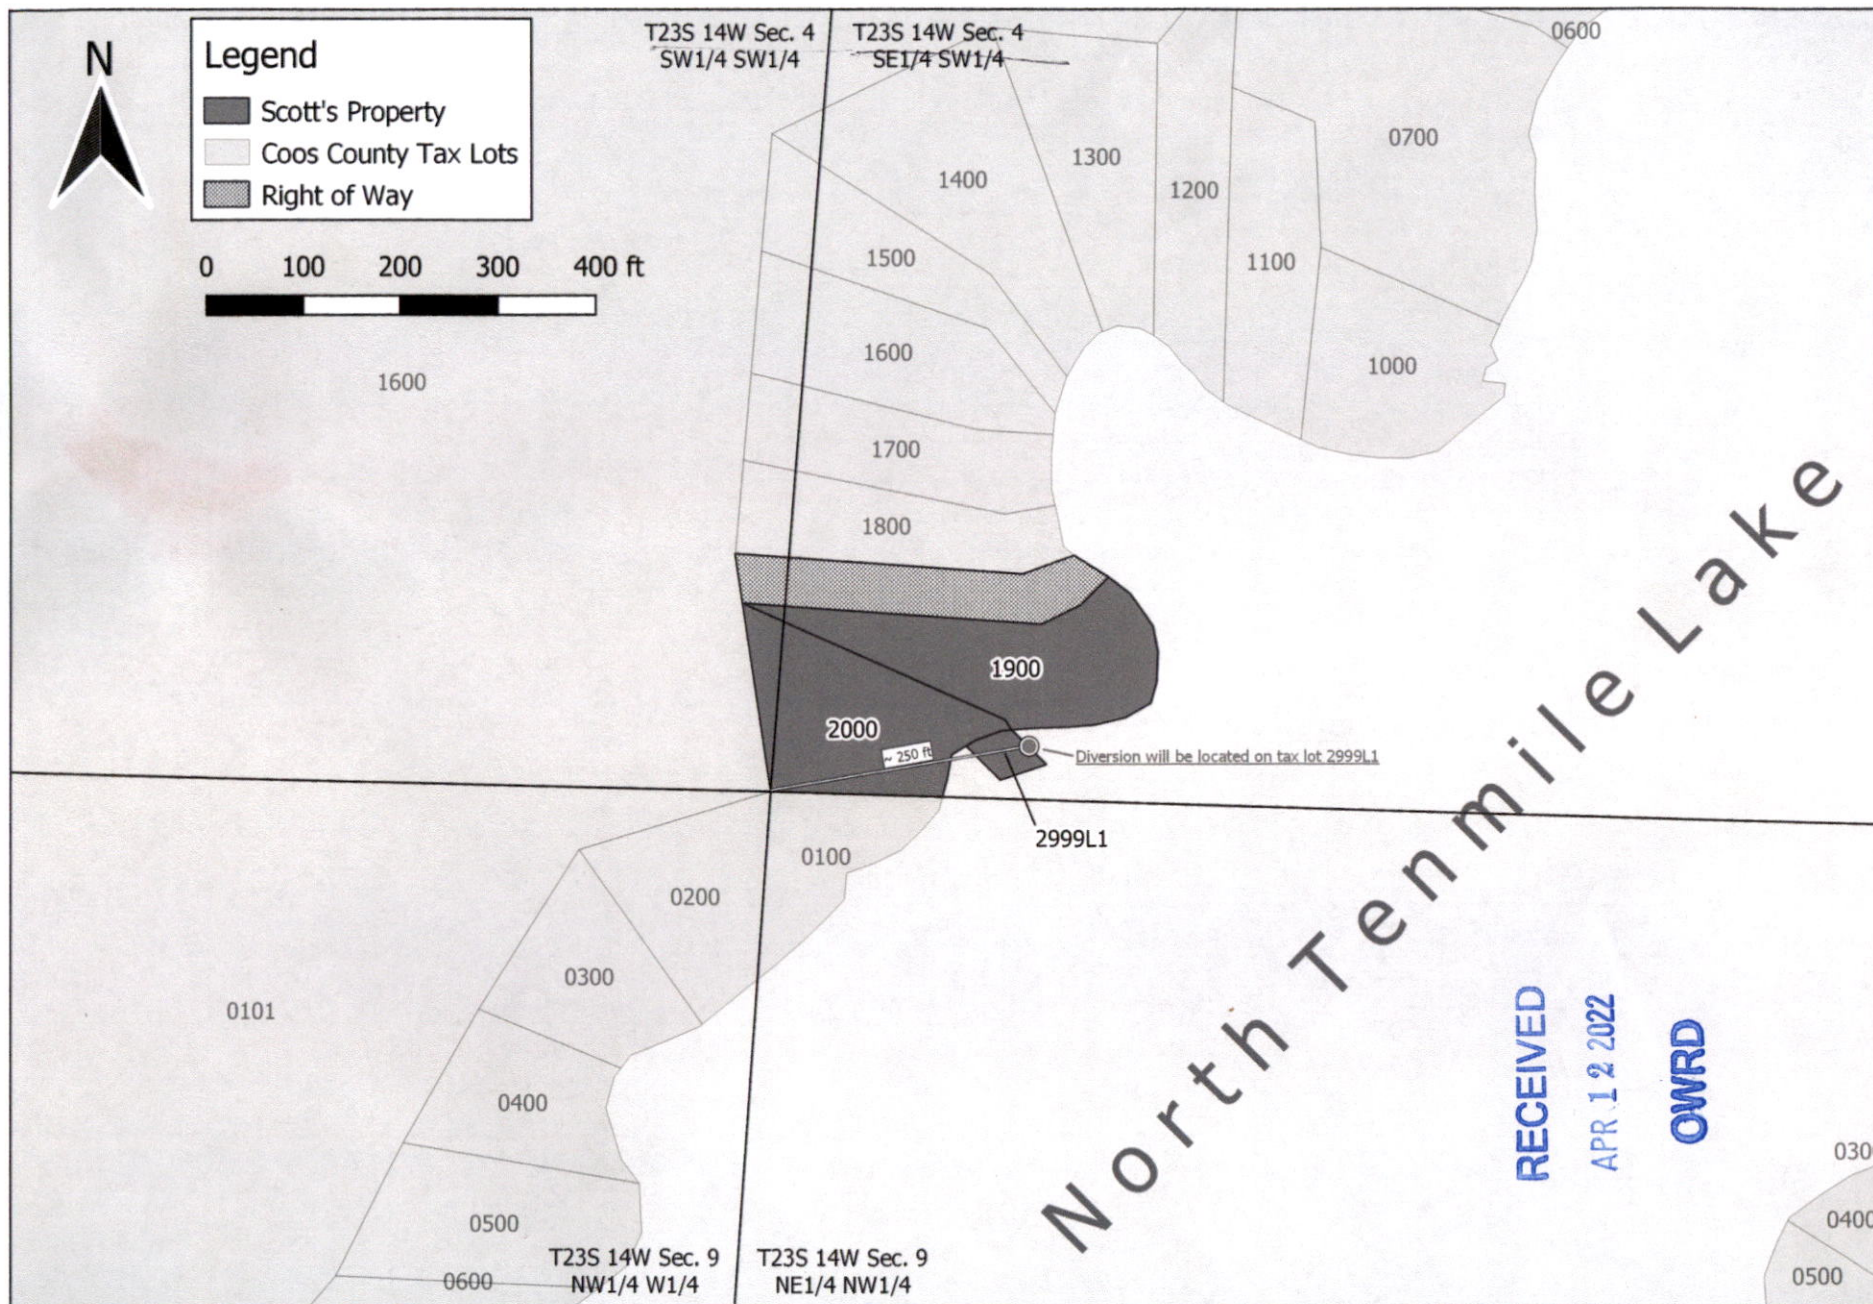

Proposed Point of Diversion Located 50 ft N and 325 ft E from the
corner of Section 4 corner of SE 1/4 SW 1/4 Section 4


1" = 600'

T 23 S, R 14 W, Sections 4 & 9

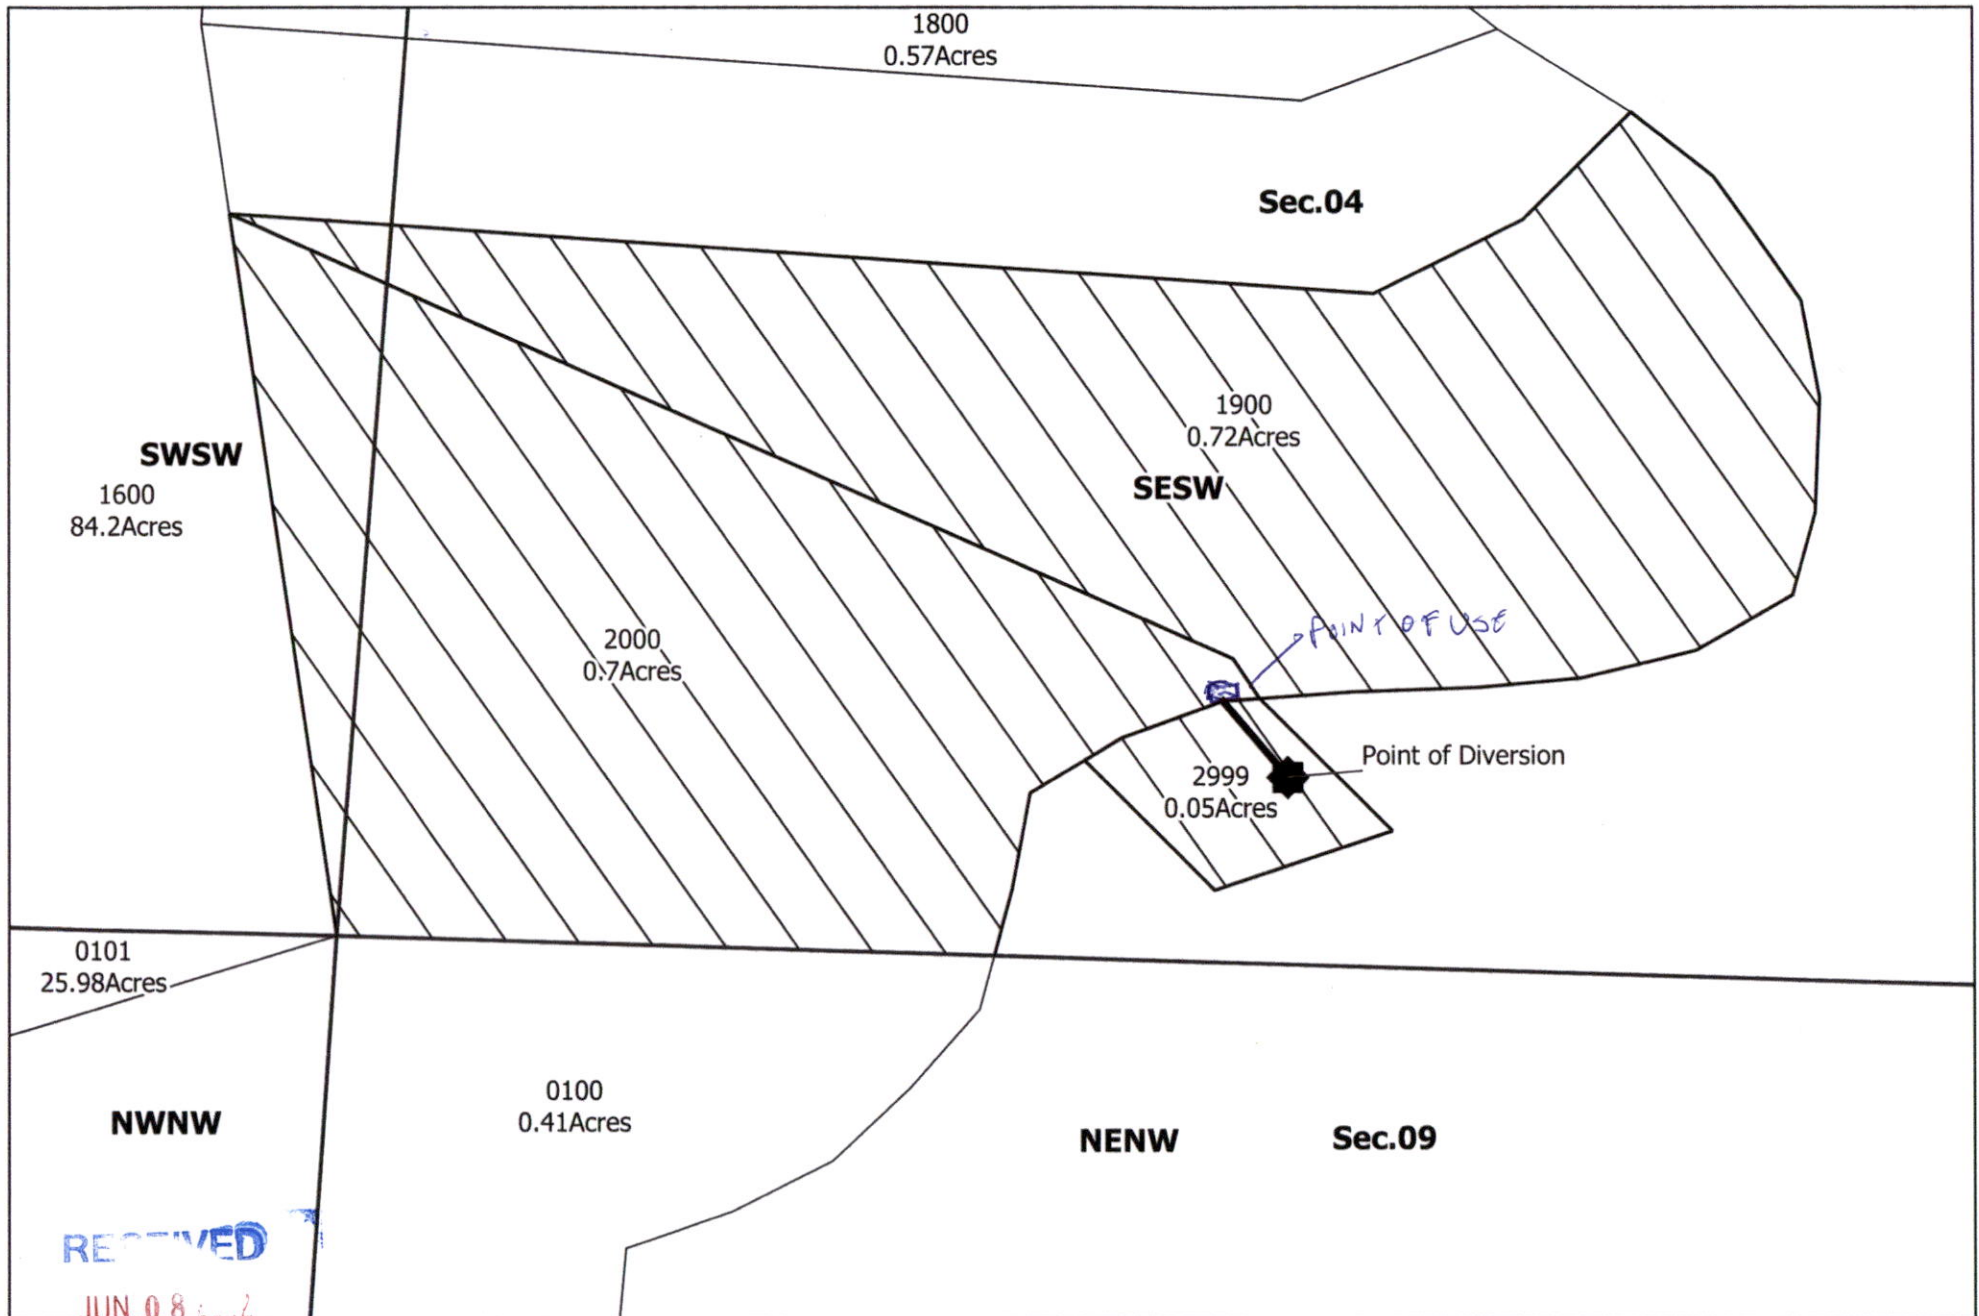

Proposed point of diversion located 50 feet North and 250 feet East from the SW corner of SE SW T 23 S, R 14 W of section 4

You are currently running an experimental version of Earth.

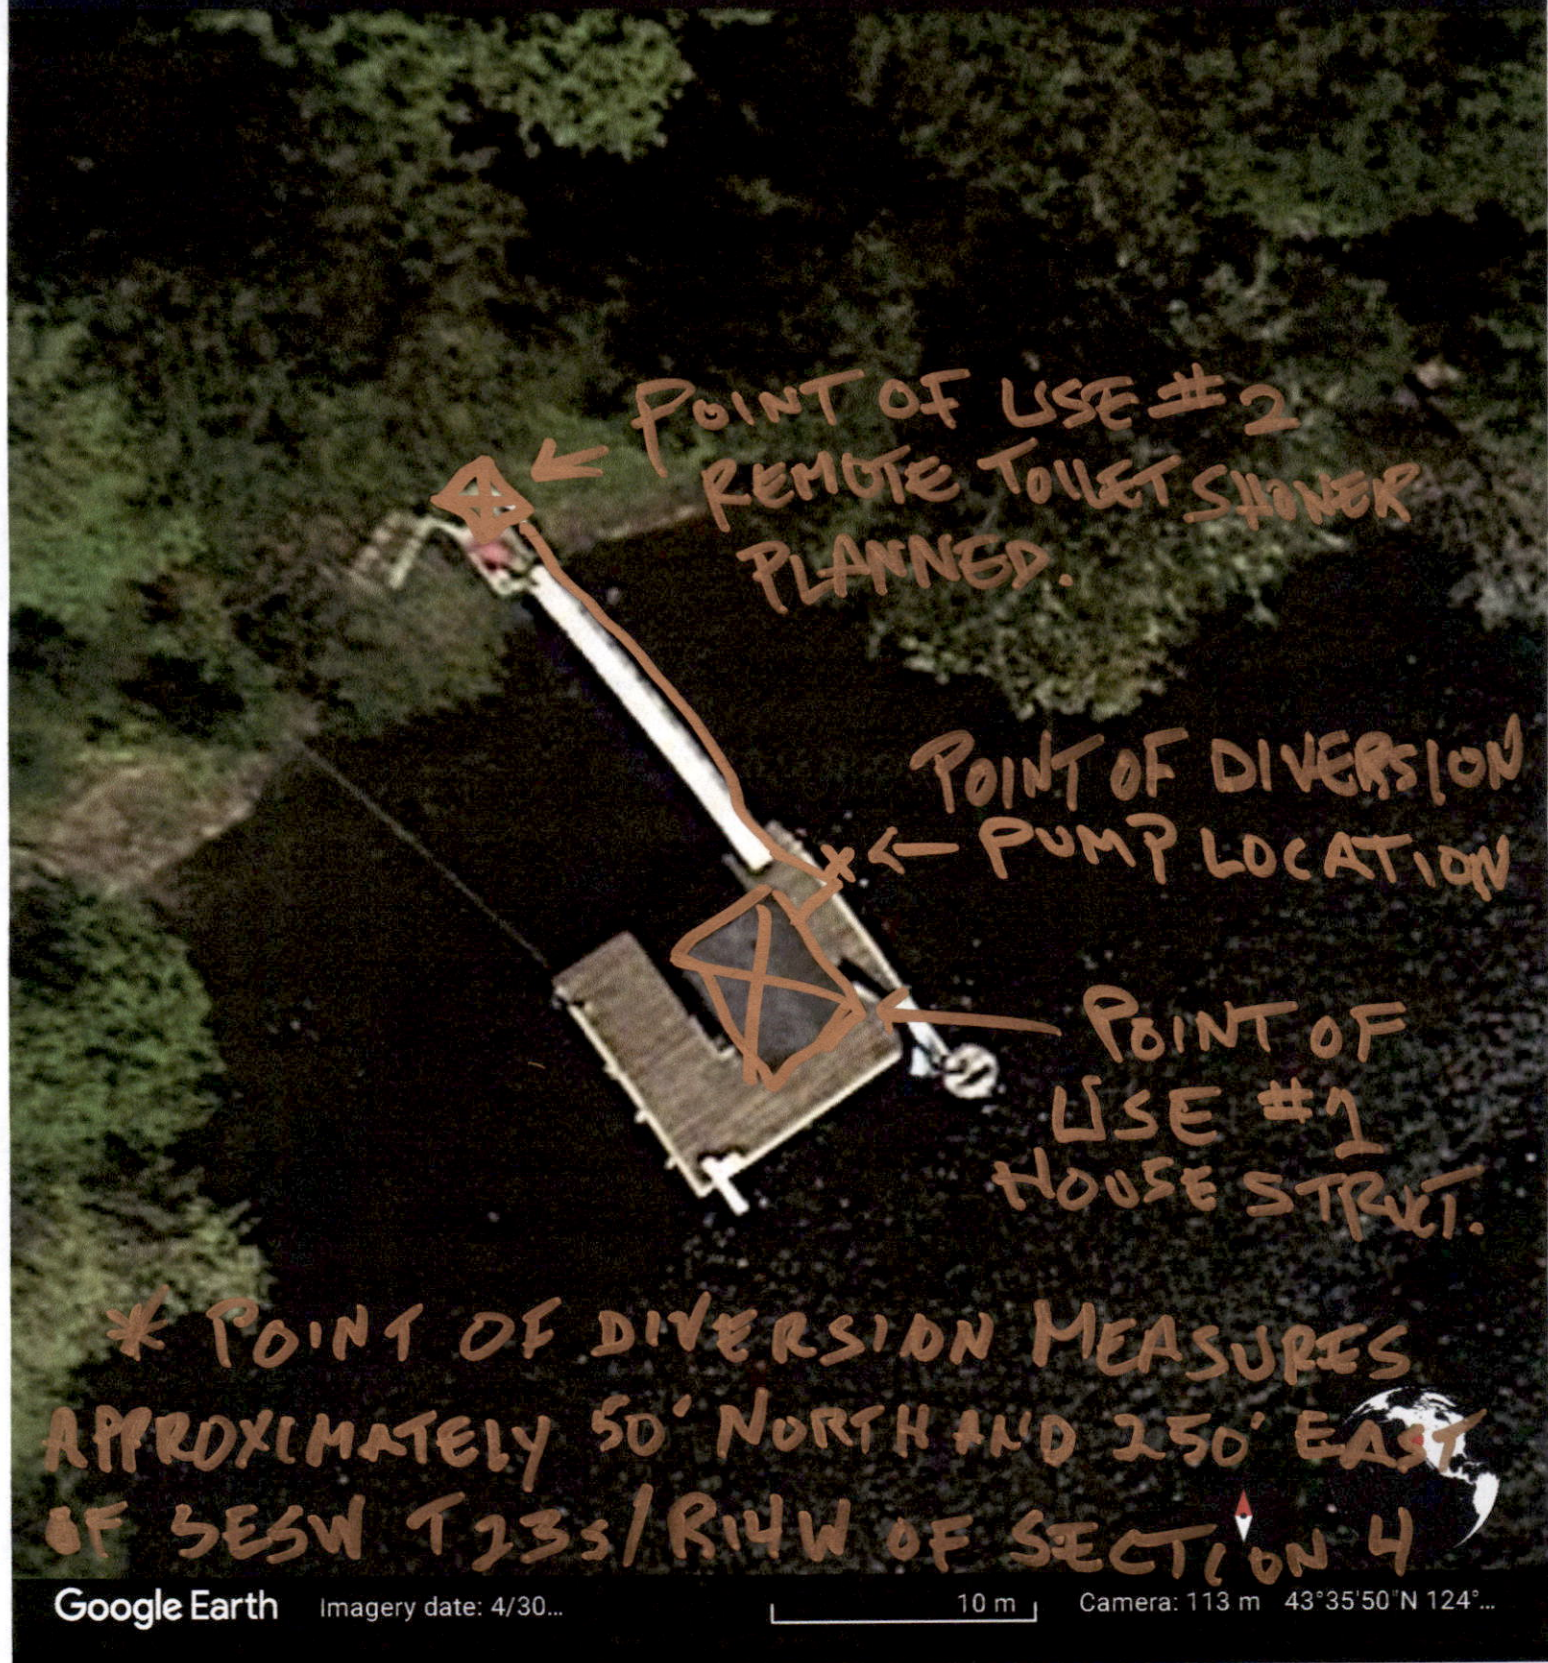[Learn more](#)[Send feedback](#)



* Pump
——— Line
———

RECEIVED

APR 12 2022

OWRD