


T. 32 S., R. 37 E., W.M.

RECEIVED

AUG 30 1999
WATER RESOURCES DEPT.
SALEM, OREGON

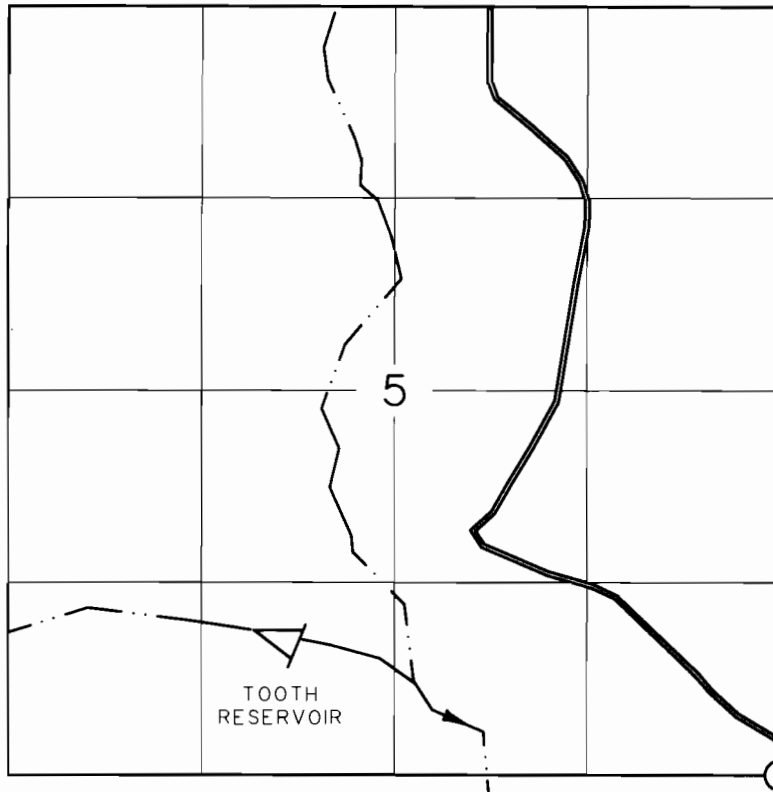

1" = 1320'

DIVERSION IS 900
FEET NORTH AND
3360 FEET WEST
OF THE SE CORNER
OF SECTION 5.


CLAIM OF BENEFICIAL USE MAP

IN NAME OF

UNITED STATES BUREAU OF LAND MANAGEMENT

APPLICATION NO. R-69377

PERMIT NO. R-11720

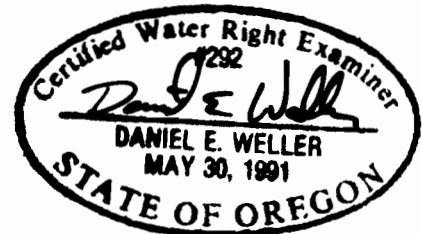

EXPIRES 6/30/00

SURVEYED: JUNE 29, 1999

THE PURPOSE OF THIS MAP IS FOR IDENTIFYING THE LOCATION OF THE WATER RIGHT ONLY AND
IS NOT INTENDED TO PROVIDE LEGAL DIMENSIONS OR LOCATION OF PROPERTY OWNERSHIP LINES

U.S. BUREAU OF LAND MANAGEMENT-OSO
BRANCH OF GEOGRAPHIC SCIENCES

DWG: TOOTH

EXECUTED BY:
DANIEL E. WELLER, PLS, CWRE
P.O. BOX 2965
PORTLAND, OREGON 97208