


T. 32 S., R. 36 E., W.M.

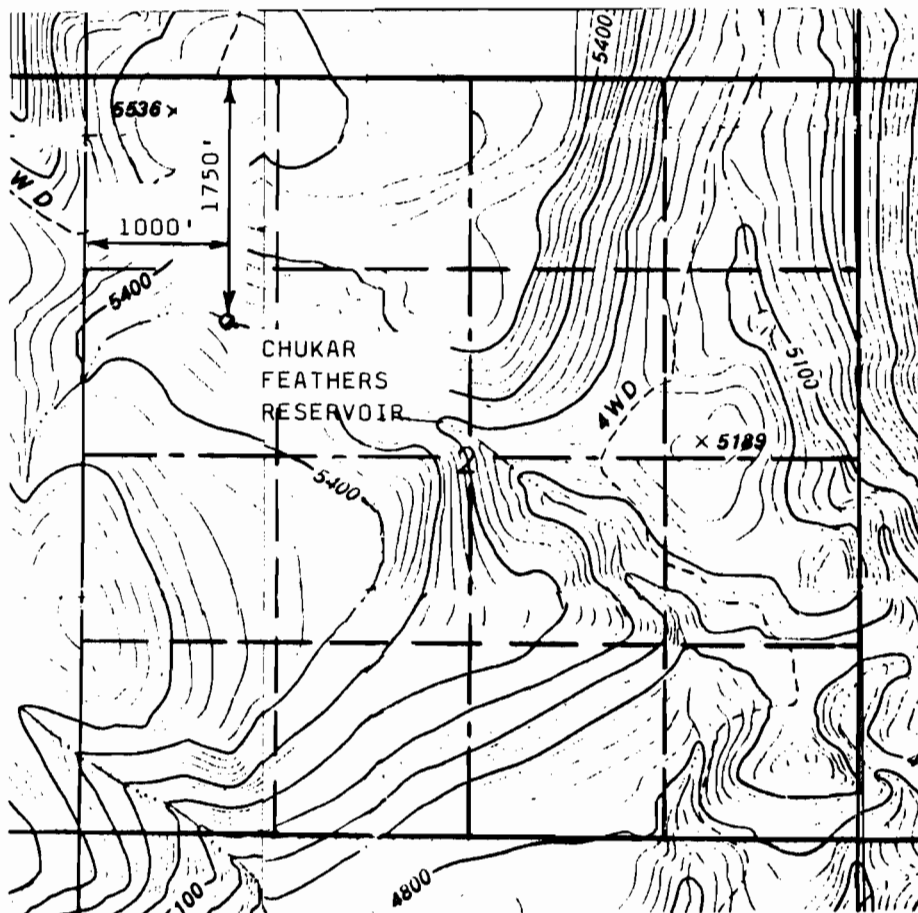

SEPA
JUL 12 1991
FEDERAL RESOURCES DEPT.
SALEM, OREGON

SCALE 1"=1320'

THE PURPOSE OF THIS MAP IS TO IDENTIFY THE LOCATION OF THE WATER RIGHT ONLY AND IS NOT INTENDED TO PROVIDE LEGAL DIMENSIONS OR LOCATIONS OF PROPERTY OWNERSHIP LINES

FINAL PROOF SURVEY UNDER

Application No. R-69378 Permit No. R-11114

IN NAME OF

U.S. BUREAU OF LAND MANAGEMENT
BURNS DISTRICT

SURVEYED June 13, 1991

