


Pond Location Marked by

1" = 1000

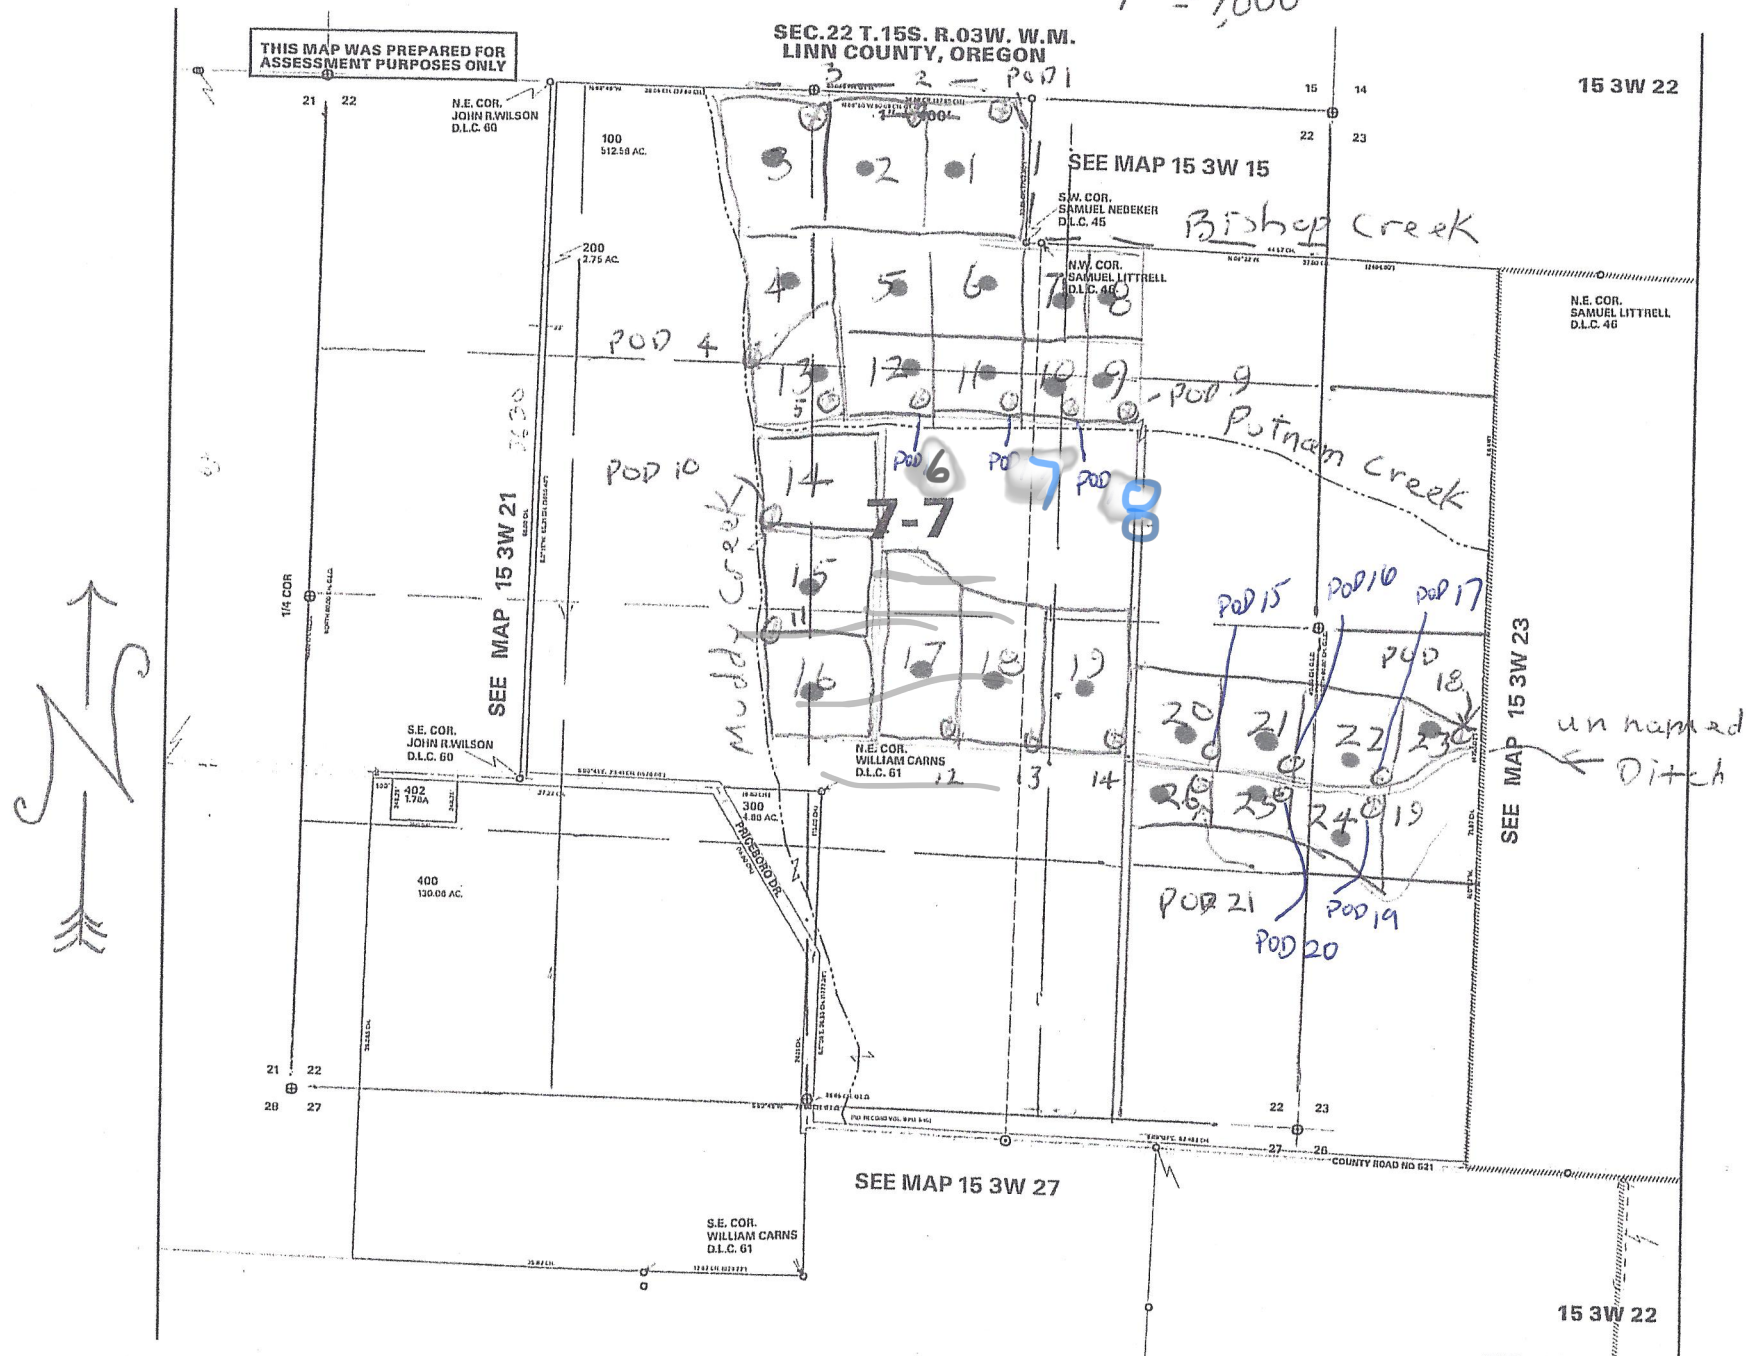

Pond #	Dist South	Dist East	Ac.	Ac Ft
1	300	1200	8.0	6.7
2	300	1700	8.4	7
3	300	2200	7.2	6
4	1100	1200	5.3	4.3
5	1000	1700	6.3	5.2
6	1000	2200	6.3	5.2
7	1000	2700	2.8	2.3
8	1000	3000	2.8	2.3
9	1500	3000	2.8	2.3
10	1500	2700	2.8	2.3
11	1500	2300	4.1	3.4
12	1500	1800	4.4	3.7
13	1500	1300	5.5	4.6
14	2000	1500	6.7	5.5
15	2500	1500	6.3	5.3
16	3100	1500	6.8	5.7
17	3000	2100	8.3	6.9
18	3000	2500	7.5	6.2
19	3000	2800	7.8	5.6
20	3200	3300	3.8	3.2
21	3200	3800	3.4	2.8
22	3200	4300	4.5	3.7
23	3200	4700	3.0	2.5
24	3600	4300	3.5	2.9
25	3600	3700	2.3	1.9
26	3600	3400	2.3	1.9

Total 109.4

All From NE Corner Wilson DLC 60

RECEIVED BY OWRD

APR 17 2017

SALEM, OR

12-88392

Point of Diversion Locations all from NE Corner Wilson DLC 60

	Dist South	Distance East	Creek
1	5	2400	Bishop
2	5	1900	"
3	5	1400	"
4	1400	1100	Muddy
5	1600	1500	Putnam
6	1600	2000	"
7	1600	2450	"
8	1600	2800	"
9	1600	3100	"
10	2200	1250	Muddy
11	2800	1250	"
12	3300	2250	Unnamed
13	3300	2600	"
14	3300	3100	"
15	3400	3600	"
16	3400	4000	"
17	3400	4500	"
18	3200	4900	"
19	3600	4450	"
20	3600	3900	"
21	3600	3400	"

Langdon Data

RECEIVED BY OWRD

APR 17 2017

SALEM, OR

R-88393