


- 1. 1S4W, SEC. 20, TAX LOT 300 U.S. BUREAU OF RECLAMATION
- 2. 1S4W, SEC. 20, TAX LOT 800 U.S. BUREAU OF RECLAMATION
- 3. 1S9W, SEC. 13, TAX LOT 1400 MATTEBSON
- 4. 1S9W, SEC. 13, TAX LOT 1300 LORAIN AND DOROTHY FAMILY TRUST
- 5. 1S9W, SEC. 13, TAX LOT 1200 STIMSON LUMBER COMPANY
- 6. 1S9W, SEC. 13, TAX LOT 1000 RAGOSINE
- 7. 1S9W, SEC. 13, TAX LOT 900 STOLLER
- 8. 1S9W, SEC. 13, TAX LOT 802 ORCHARD FEDERAL SAVINGS BANK
- 9. 1S9W, SEC. 13, TAX LOT 700 MATTEBSON
- 10. 1S4W, SEC. 18, TAX LOT 400 MATTEBSON
- 11. 1S9W, SEC. 12, TAX LOT 502 SCOTT
- 12. 1S9W, SEC. 12, TAX LOT 400 SCOGGINS CREEK HARVESTING CORP
- 13. 1S9W, SEC. 12, TAX LOT 300 CARMEL MINISTRIES
- 14. 1S9W, SEC. 12, TAX LOT 200 PENNE (FARM AND RANCH ASSET MANAGEMENT)
- 15. 1S4W, SEC. 6, TAX LOT 1700 STUTZ
- 16. 1S4W, SEC. 6, TAX LOT 1600 GULLORY
- 17. 1S4W, SEC. 5, TAX LOT 800 KELLEY
- 18. 1S4W, SEC. 5, TAX LOT 900 WATKINS
- 19. 1S4W, SEC. 8, TAX LOT 900 IRWIN
- 20. 1S4W, SEC. 8, TAX LOT 1200 STIMSON LUMBER COMPANY
- 21. 1S4W, TAX LOT 4900 U.S. BUREAU OF RECLAMATION

- 22. 1S4W, TAX LOT 4900 U.S. BUREAU OF RECLAMATION
- 23. 1S4W, SEC. 21, TAX LOT 2190 STIMSON LUMBER COMPANY
- 24. 1S4W, SEC. 21, TAX LOT 500 STIMSON LUMBER COMPANY
- 25. 1S4W, SEC. 28, TAX LOT 190 WALTA, EULA M. C/O STIMSON LUMBER COMPANY
- 26. 1S4W, SEC. 28, TAX LOT 100 STIMSON LUMBER COMPANY
- 27. 1S4W, SEC. 27, TAX LOT 600 FOREST FIBER PRODUCTS CO BY FORESTEX CO
- 28. 1S4W, SEC. 27, TAX LOT 700 PAYNE, LESLIE O. AND INEZ, R.
- 29. 1S4W, SEC. 27, TAX LOT 800 FOREST FIBER PRODUCTS CO BY FORESTEX CO
- 30. 1S4W, SEC. 27, TAX LOT 900 SPAHN
- 31. 1S4W, SEC. 27, TAX LOT 200 GENDRES, LUTHER REVOC LIVING TRUST
- 32. 1S4W, SEC. 27, TAX LOT 201 U.S. BUREAU OF RECLAMATION
- 33. 1S4W, SEC. 26, TAX LOT 401 U.S. BUREAU OF RECLAMATION
- 34. 1S4W, SEC. 26, TAX LOT 400 SCHMIDT AND KLECAN
- 35. 1S4W, SEC. 23, TAX LOT 1705 U.S. BUREAU OF RECLAMATION
- 36. 1S4W, SEC. 23, TAX LOT 1700 BLACK, EVAN ELIZABETH - TRUSTEE
- 37. 1S4W, SEC. 23, TAX LOT 1903 TRIP
- 38. 1S4W, SEC. 23, TAX LOT 1901 HUTCHISON
- 39. 1S4W, SEC. 23, TAX LOT 2301 WILLIAMS
- 40. 1S4W, SEC. 23, TAX LOT 2400 JOINT WATER COMMISSION
- 41. 1S4W, SEC. 24, TAX LOT 801 JOINT WATER COMMISSION
- 42. 1S4W, SEC. 24, TAX LOT 900 JOINT WATER COMMISSION

- 43. 1S4W, SEC. 13, TAX LOT 3500 JOINT WATER COMMISSION
- 44. 1S4W, SEC. 13, TAX LOT 1100 BRADLEY
- 45. 1S4W, SEC. 13, TAX LOT 101 POWELL
- 46. 1S4W, SEC. 13, TAX LOT 700 NUTSCH AND PLYMATE
- 47. 1S3W, SEC. 18, TAX LOT 600 METRO PARK AND GREENSPACES
- 48. 1S3W, SEC. 18, TAX LOT 500 METRO PARK AND GREENSPACES
- 49. 1S3W, SEC. 18, TAX LOT 400 KNOX
- 50. 1S3W, SEC. 18, TAX LOT 301 JOINT WATER COMMISSION
- 51. 1S3W, SEC. 18, TAX LOT 103 HILLSBORO, FOREST GROVE, CO OWNER BEAVERTON UTILITIES
- 52. 1S3W, SEC. 18, TAX LOT 200 CITY OF HILLSBORO
- 53. 1S3W, SEC. 18, TAX LOT 100 METRO, CO OWNER PARKS GREENSPACES
- 54. 1S3W, SEC. 18, TAX LOT 203 PORTLAND GENERAL ELECTRIC
- 55. 1S3W, SEC. 18, TAX LOT 101 U.S. BUREAU OF RECLAMATION
- 56. 1S3W, SEC. 7, TAX LOT 101 U.S. BUREAU OF RECLAMATION
- 57. 1S3W, SEC. 8, TAX LOT 600 MILFORD G. HOVDA - CO OWNER - MARGARET R.

THIS MAP IS FOR THE PURPOSE OF IDENTIFYING THE LOCATION OF THE WATER RIGHT BOUNDARIES ONLY AND IS NOT INTENDED TO PROVIDE LEGAL DIMENSIONS OR LOCATIONS OF PROPERTY LINES.

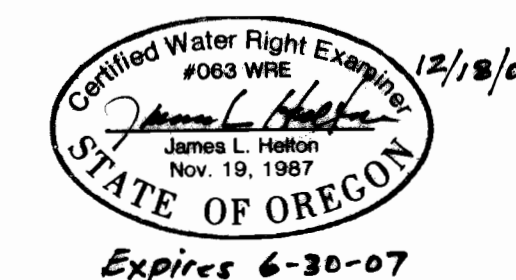

TUALATIN BASIN WATER SUPPLY PROJECT
 PROPOSED HAGG LAKE RESERVOIR EXPANSION
 AND POINTS OF DIVERSION
 OCTOBER 2006

RECEIVED
 DEC 21 2006
 WATER RESOURCES DEPT
 SALEM OREGON

