


# SECTION 2, TWP.3 S. RANGE 16 E. W.M. SHERMAN COUNTY, OREGON

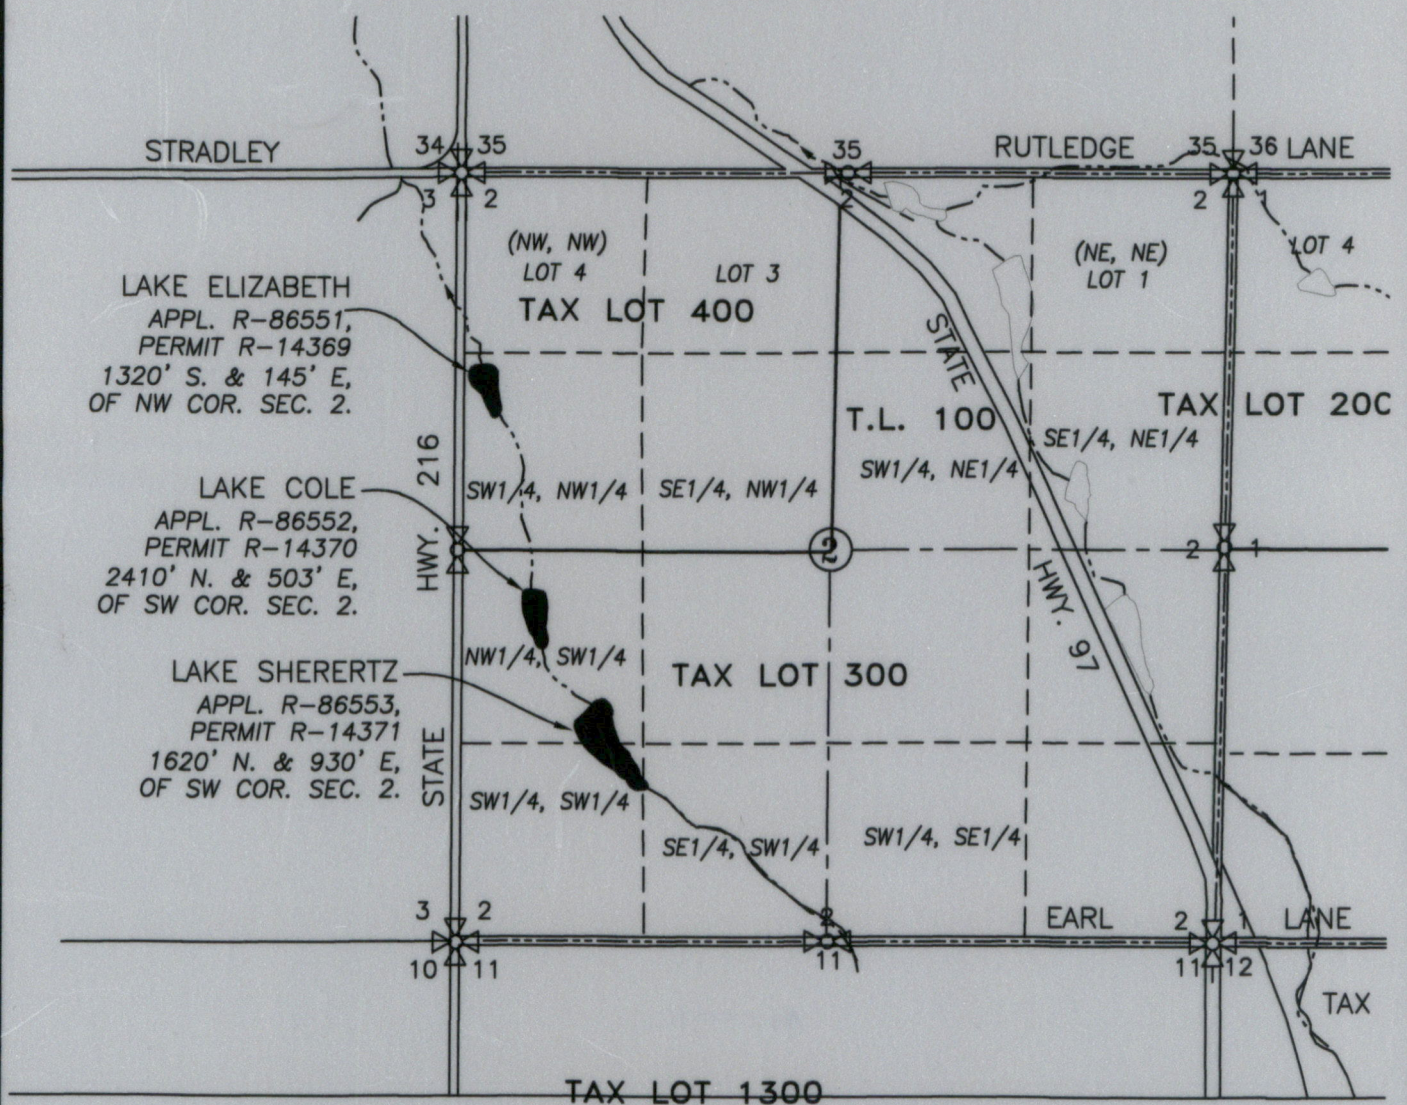

## LEGEND :

- RESERVOIR (LAKE)
- STREAM WITH DIRECTIONAL FLOW

RECEIVED

JUN 14 2022

OWRD



## CLAIM OF BENEFICIAL USE MAP

SCALE: 1" = 1320'  
0' 660' 1320' 2640'

COBU MAP #  
**2025**


APPLICATION No. R-86551, R-86552, R-86553

PERMIT No. R-14369, R-14370, R-14371

IN THE NAME OF:

BUCK HOLLOW RANCH, INC.

DATE: MAY 10, 2022

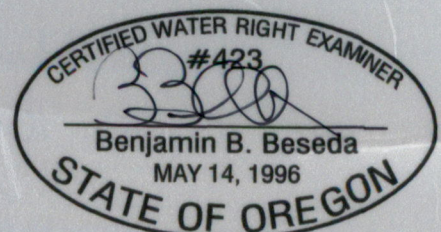

EXPIRES: 12/31/2023

BY: **TENNESON ENGINEERING CORP.**  
3775 CRATES WAY  
THE DALLES, OREGON. 97058  
PH. 541-296-9177  
FAX 541-296-6657



### NOTE:

"THIS MAP IS NOT INTENDED TO PROVIDE  
LEGAL DIMENSIONS OR LOCATIONS OF  
PROPERTY OWNERSHIP LINES."

W.O. #12028