

**CLAIM OF
BENEFICIAL USE
for Reservoirs storing less than
9.2 acre-feet permitted under
ORS 537.409**



Oregon Water Resources Department
725 Summer Street NE, Suite A
Salem, Oregon 97301-1266
(503) 986-0900
www.oregon.gov/OWRD

RECEIVED

JUN 23 2022

OWRD

**A fee of \$230 must accompany this form.
The Claim will be returned if the fee is not included.**

This form may be completed by the permit holder of record if:

- 1) The permit was issued under the authority of ORS 537.409; and
- 2) No secondary permit exists for the use of water stored in the reservoir; and
- 3) The developed capacity of the reservoir is less than 9.2 acre-feet; and
- 4) The water was stored by the date required in the permit; and

A separate form shall be completed for each permit.

This form must be submitted to the Water Resources Department within one year of storage of water in the reservoir.

Please type or print in dark ink. If the data provided is found to contain errors or omissions, it may be returned. The Department may require the submittal of additional information.

If you have questions regarding the completion of this form, please call 503-979-9103.

SECTION 1

GENERAL INFORMATION

File Information:

APPLICATION # R- 86128	PERMIT # 14125 R- 26128 60
---------------------------	--

Applicant Information:

APPLICANT NAME Holly Bamber		PHONE NO. 360-621-5541	ADDITIONAL CONTACT NO.	
ADDRESS 19831 S. Henrici Rd				
CITY Oregon City	STATE OR	ZIP 97045	E-MAIL	

**SECTION 2
RESERVOIR INFORMATION**

Reservoir Dimensions and Capacity:

	AVERAGE LENGTH	AVERAGE WIDTH	AVERAGE DEPTH	MAXIMUM CAPACITY IN ACRE-FEET
B.P. POND	140'	35'	4'	.4
	140'	35'	5'	.6

Total = 1 acre ft.

To determine capacity in acre-feet use for the above table, use the following calculation:

$$\text{Acre-feet} = \frac{(\text{Average Length})(\text{Average Width})(\text{Average Depth})}{43,560}$$

RECEIVED

JUN 23 2022

SECTION 3

MAP

OWRD

Attach a map identifying the reservoir location. If the water right application map accurately reflects the location of the reservoir, you may attach a copy of it. Otherwise, you must submit a map meeting the standards of OAR 690-310-0050, which are attached.

Preparation of the map by a Certified Water Rights Examiner is **not** required for this type of permit, but may be submitted.


(MAP & pictures Enclosed)


SECTION 4

SIGNATURE

This Claim of Beneficial Use must be signed by each permit holder of record.

By my signature, I certify that the information contained herein is true and correct to the best of my knowledge.

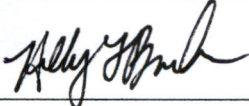SIGNATURE	PRINT OR TYPE NAME	TITLE	DATE
	Holly Bamber	Property OWNER	6/1/22

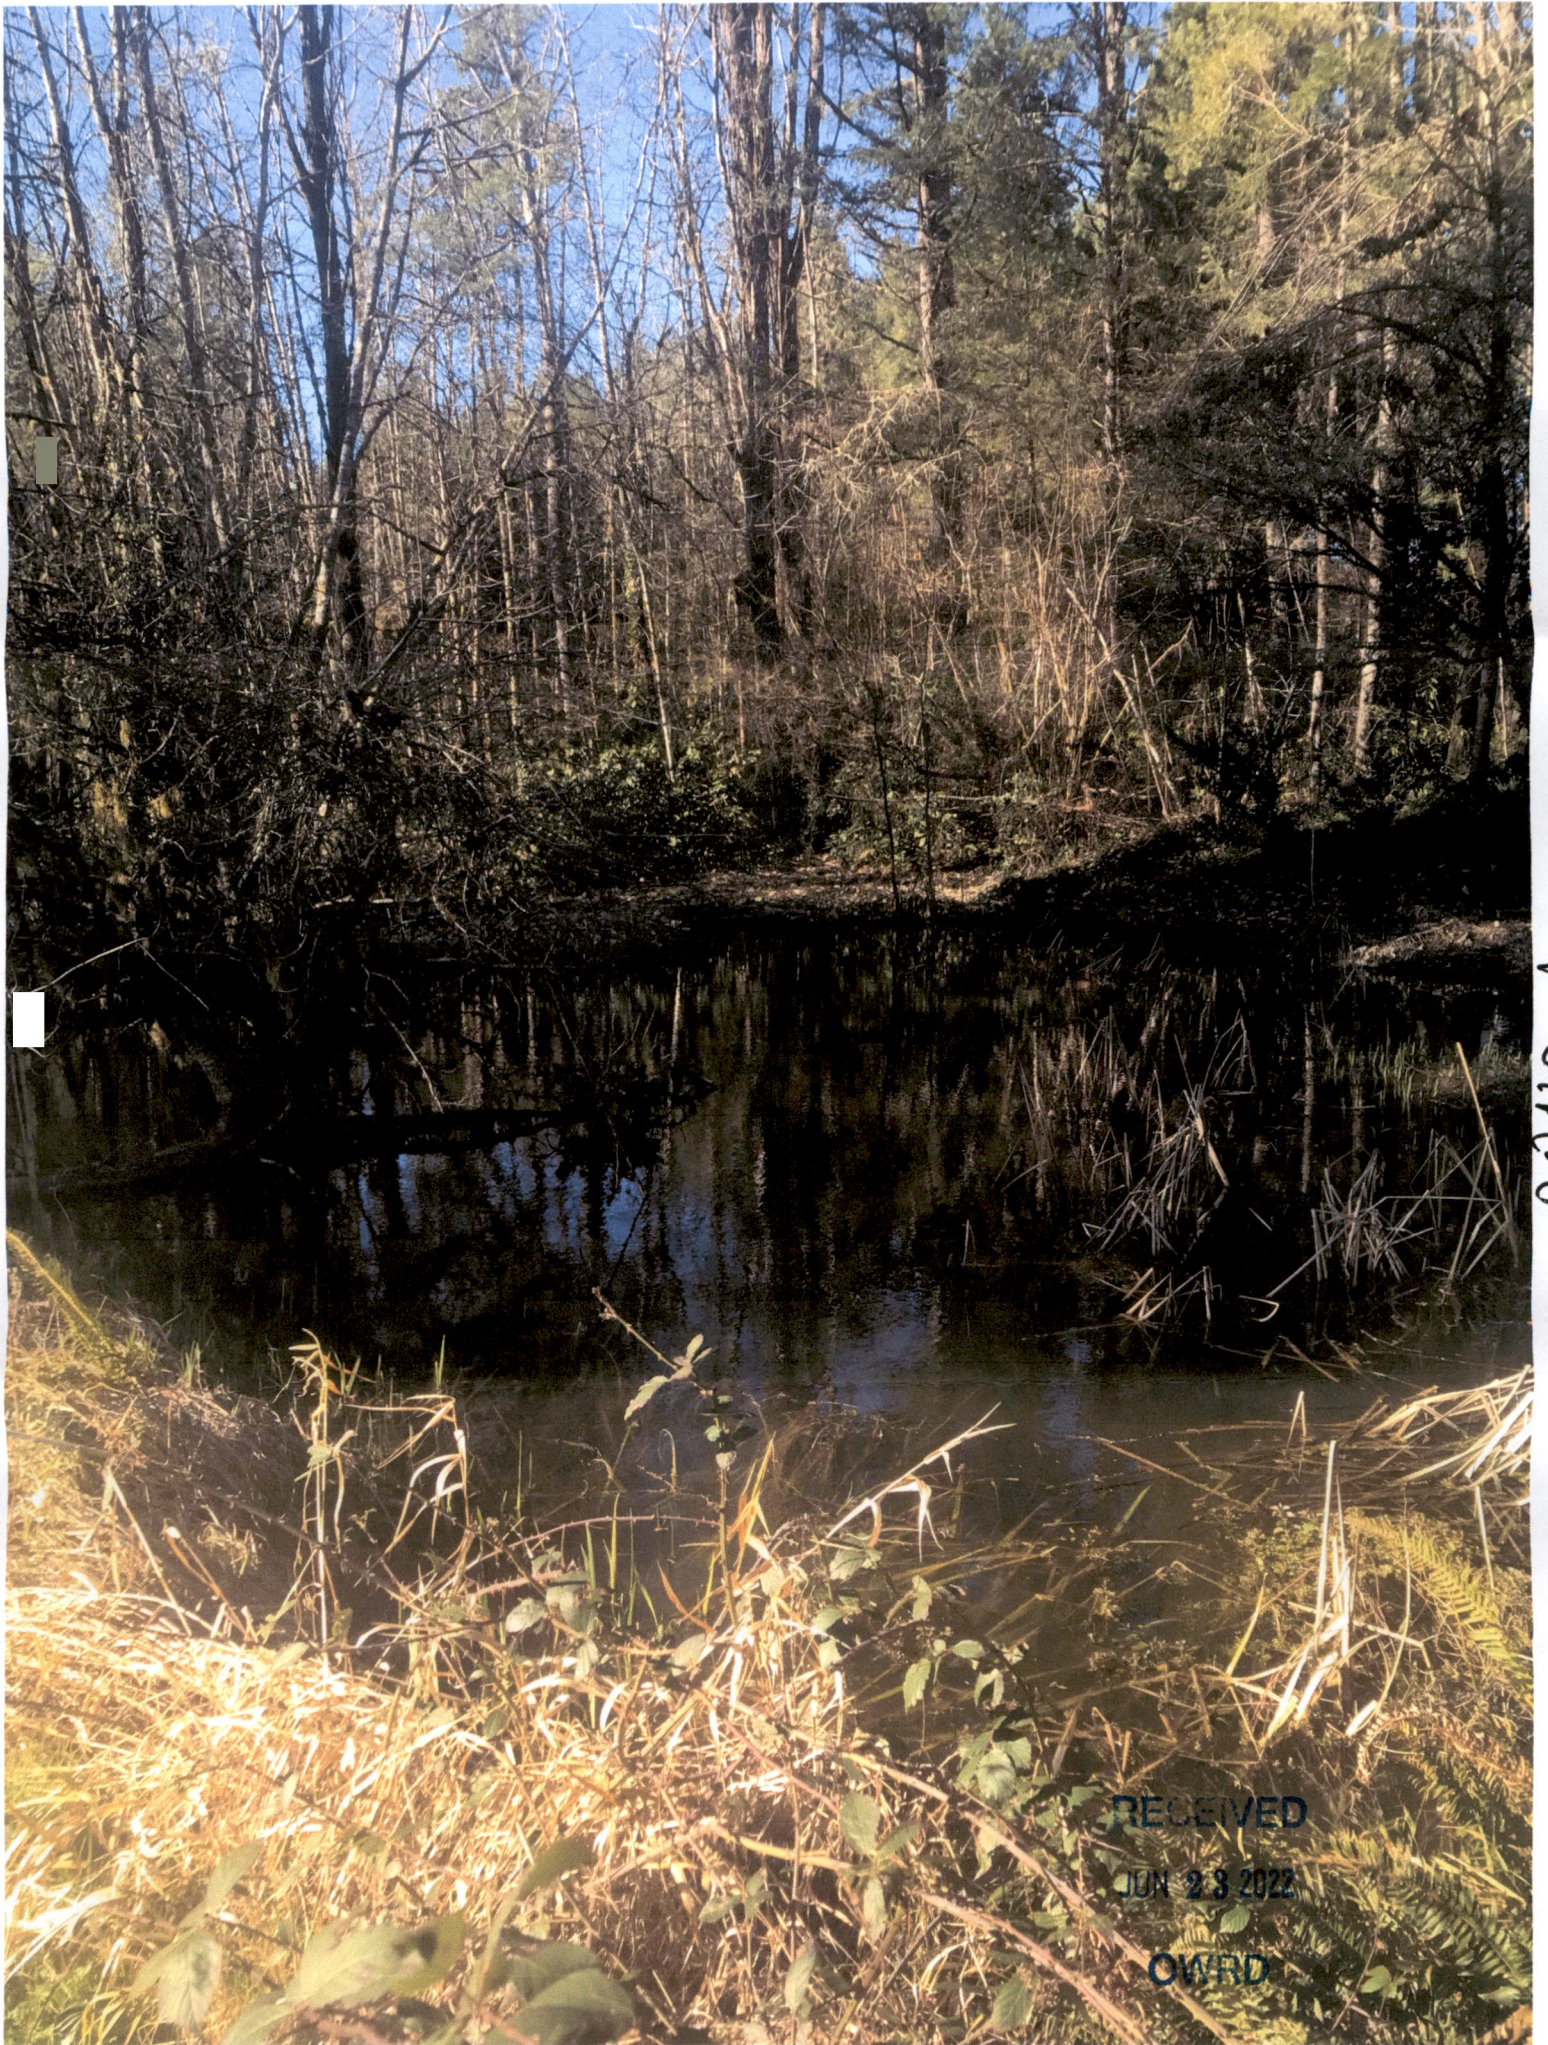

POND A

RECEIVED

JUN 23 2022

OWRD



PAID R

RE
JAN 2
19