


Claim of Beneficial Use

Sidney Irrigation Cooperative / US Fish and Wildlife Service
Transfer T-11545

Township 9S, Range 3W, W.M.

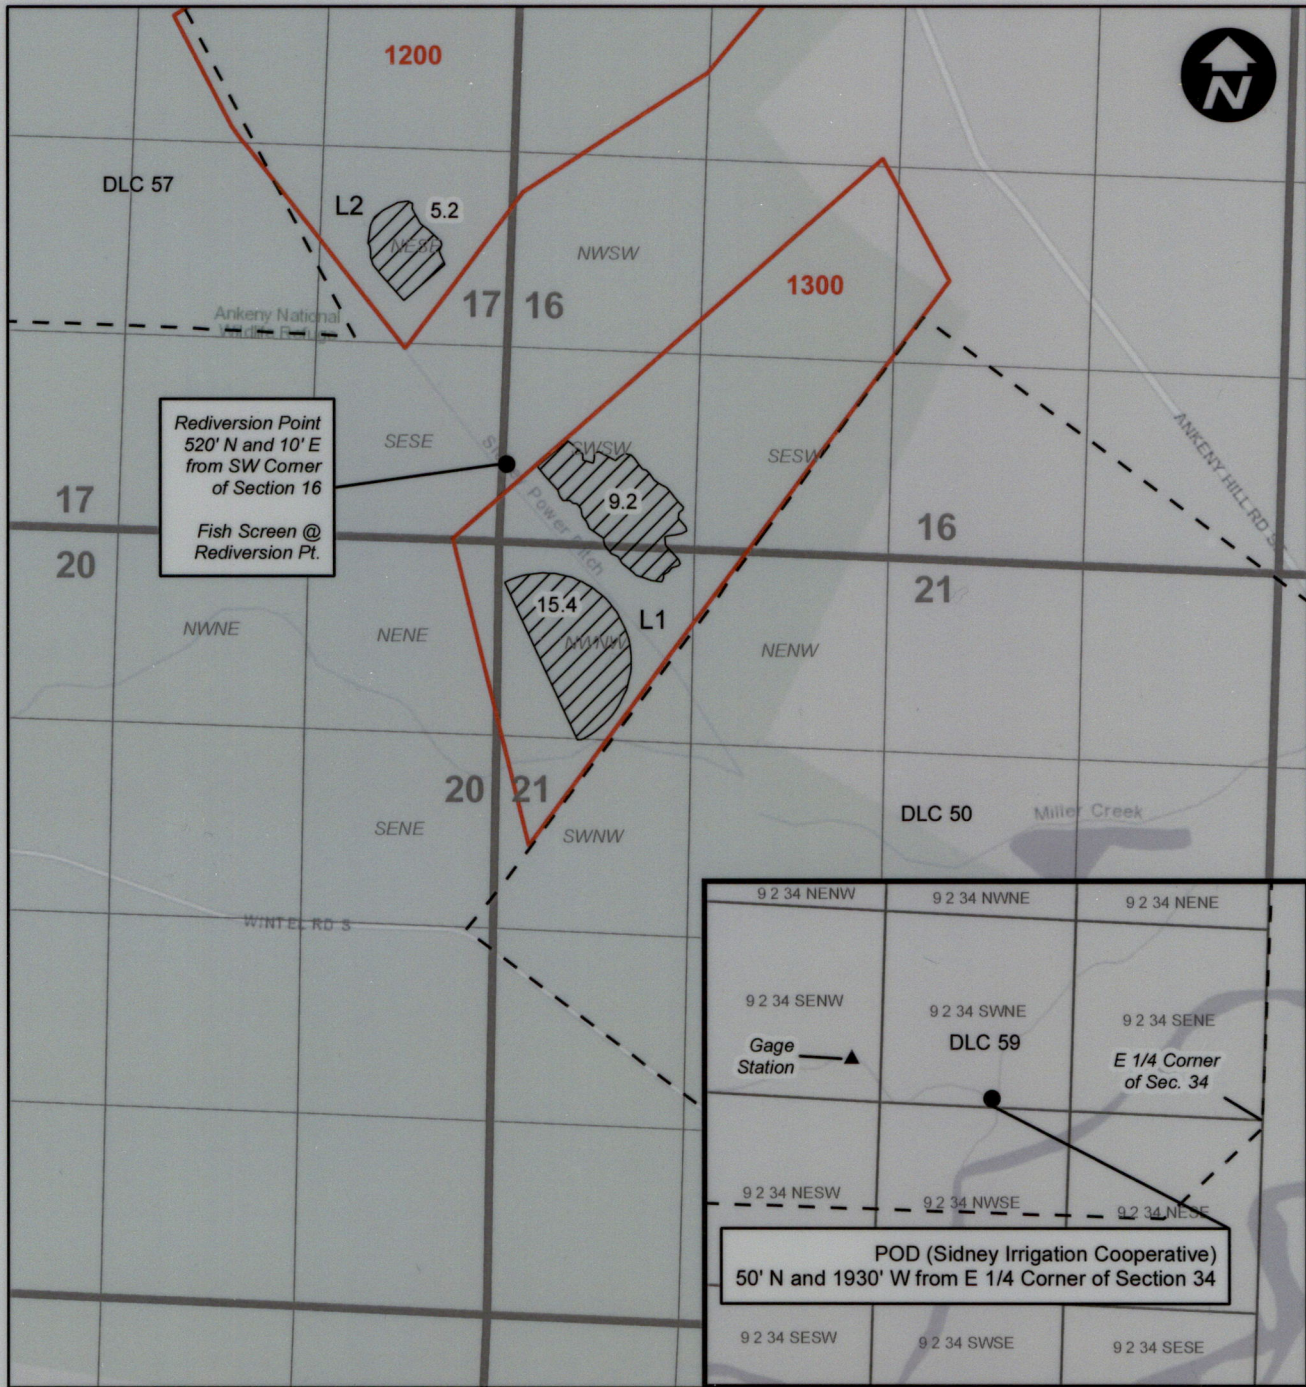

This map is not intended to provide legal dimensions or locations of property ownership lines.



Legend

- Place of Use
- Tax Lot
- DLC

0 660 1,320 2,640 Feet

RECEIVED

JUN 24 2022

OWRD