




T. 35 & 36 S., R. 1 E., W.M.

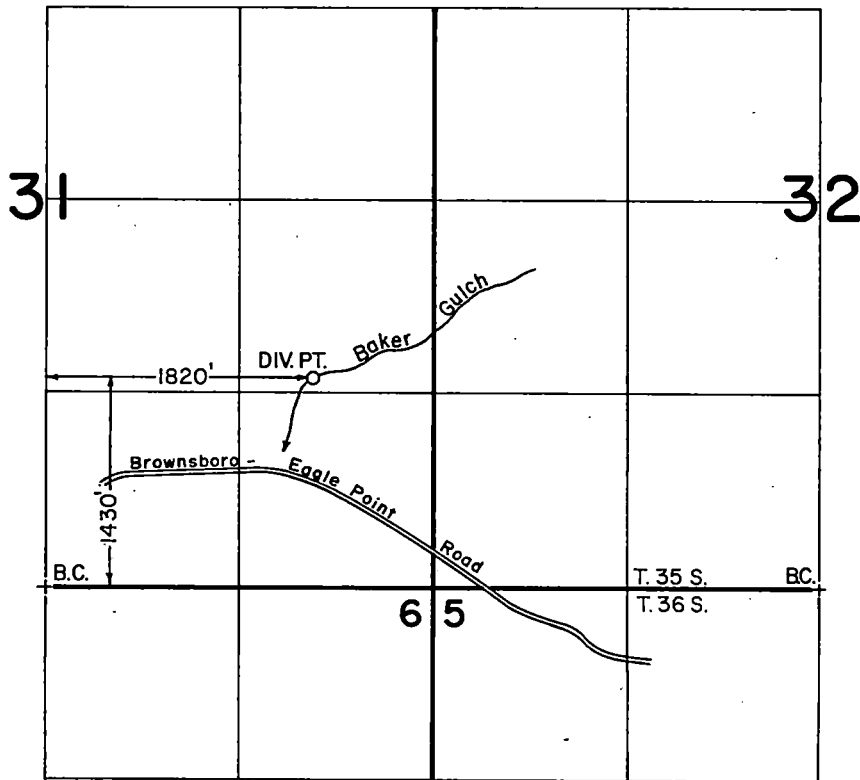

SCALE: 1" = 1320'

FINAL PROOF SURVEY

UNDER

TRANSFER NO. 5170

TRANSFER NO. 4882

Application No. Permit No.

IN NAME OF

JIMMY LEE & JUDY E. DENNY - STEPHEN HARBISON

Surveyed AUG. 23. 1989, by B. S. JAMES.....

140' E. 1416.67' BROPHY ROAD

RECEIVED

AUG 28 1981
WATER RESOURCES DEPT
SALEM, OREGON

35 1E 32

T-4882

RECEIVED

JUL 2 1981

WATER RESOURCES DEPT
SALEM, OREGON

9-19

NWSE

1.7 NWSE ±
6.3 SWSE ±

NESE

old ditch & boundary of irrigated lands per app map.

GOV'T LOT 3

GOV'T LOT 2

1273.8'

L.O.
Parcel III, II, I

BAKER GULCH

New DIVERSION
DNDY LINE ACFT. 67-06720

401

503 (P-6848)

504

501

40 AC
P-4376
9 AC

700

(P-1929)

(P-3672)

GOV'T LOT 1 (P-2920)

801 (P-4263)

805

803 (P-3789)

802

MAP TO Accompany Application
OF Jimmy LEE AND/OR JUDY E DENNY
FOR CHANGE IN POINT OF DIVERSION
ON PERMIT 17868, Priority 8-18-47

SEE MAP

BROWNSBORO EAGLE POINT

N

32