

**CLAIM OF
BENEFICIAL USE
for Reservoir Permits by
CWRE's (not self-certified)**



Oregon Water Resources Department
725 Summer Street NE, Suite A
Salem, Oregon 97301-1266
(503) 986-0900
www.oregon.gov/OWRD

RECEIVED

JUL 05 2022

OWRD

**A fee of \$230 must accompany this form for permits
with priority dates of July 9, 1987, or later.**

Claims received without the correct fee of \$200 will be returned.

A separate form shall be completed for each permit.

In cases where a permit has been amended through the permit amendment process, a separate claim for the permit amendment is not required. Incorporate the permit amendment into the claim for the permit.

This form is subject to revision. **Begin each new claim** by checking for a new version of this form at:
<https://www.oregon.gov/OWRD/Forms/Pages/default.aspx>

The completion of this form is required by OAR 690-014-0100(1) and 690-014-0110(4).

Please type or print in dark ink. If this form is found to contain errors or omissions, it may be returned to you. **Every item must have a response.** If any requested information does not apply to the claim, insert "NA." **Do not delete or alter any section of this form unless directed by the form.** The Department may require the submittal of additional information from any water user or authorized agent.

"Section 8" of this form is intended to aid in the completion of this form and should not be submitted.

If you have questions regarding the completion of this form, please call 503-979-9103.

The Department has a program that allows it to enter into a voluntary agreement with an applicant for expedited services. Under such an agreement, the applicant pays the cost to hire additional staff that would not otherwise be available. This program means a certificate may be issued in about a month. For more information on this program see:

<https://www.oregon.gov/OWRD/programs/WaterRights/RA/Pages/default.aspx>

SECTION 1

GENERAL INFORMATION

1. File Information

APPLICATION #	PERMIT # (IF APPLICABLE)	PERMIT AMENDMENT # (IF APPLICABLE)
R-87815	R-15003	

2. Property Owner (current owner information)

APPLICANT/BUSINESS NAME Ann E. Leschen		PHONE NO. (509) 301-4521	ADDITIONAL CONTACT NO.
ADDRESS 28600 Jones Dr.			
CITY Foster	STATE OR	ZIP 97345	E-MAIL anneleschen@hotmail.com

If the current property owner is not the permit holder of record, it is recommended that an assignment be filed with the Department. ***Each permit holder of record must sign this form.***

3. Permit holder of record (this may, or may not, be the current property owner)

PERMIT HOLDER OF RECORD Ann E. Leschen			RECEIVED JUL 05 2022
ADDRESS 28600 Jones Dr.			
CITY Foster	STATE OR	ZIP 97345	OWRD

ADDITIONAL PERMIT HOLDER OF RECORD		
ADDRESS		
CITY	STATE	ZIP

4. Date of Site Inspection:

6-9-2022

5. Person(s) interviewed and description of their association with the project:

NAME	DATE	ASSOCIATION WITH THE PROJECT
Ann E. Leschen	6-9-2022	Owner

6. County

Linn

7. If any property described in the place of use of the permit final order is excluded from this report, identify the owner of record for that property (ORS 537.230(5)):

OWNER OF RECORD		
ADDRESS		
CITY	STATE	ZIP

Add additional tables for owners of record as needed

SECTION 2
SIGNATURES

OWRD

CWRE Statement, Seal and Signature

The facts contained in this Claim of Beneficial Use are true and correct to the best of my knowledge.



CWRE NAME William E. McGill		PHONE NO. (503) 510-3026	ADDITIONAL CONTACT NO. (503) 931-0210
ADDRESS 15333 Pletzer Rd. SE			
CITY Turner	STATE OR	ZIP 97392	E-MAIL willmcgill.surveying@gmail.com

Permit Holder's of Record Signature or Acknowledgement

Each permit or transfer holder of record must sign this form in the space provided below.

The facts contained in this Claim of Beneficial Use are true and correct to the best of my knowledge. I request that the Department issue a water right certificate.

SIGNATURE	PRINT OR TYPE NAME	TITLE	DATE
<i>Ann E Leschen</i>	Ann E Leschen	land owner	6-30-22

CLAIM DESCRIPTION

OWRD

1. Reservoir source and, if from surface water, the tributary:

RESERVOIR NAME OR NUMBER	SOURCE	TRIBUTARY
1- Big Pond	Unnamed stream	Gedney Creek
2- Catfish Pond	Unnamed stream	Gedney Creek
3- Trout Pond	Unnamed stream	Gedney Creek
4- Dike Pond	Unnamed stream	Gedney Creek
5- Orchard Pond	Unnamed stream	Gedney Creek

2. Developed use(s), period of use, and acre foot (af) for each use:

RESERVOIR NAME OR NUMBER	USES	SEASON OR MONTHS WHEN WATER WAS APPROPRIATED FOR STORAGE	VOLUME STORED (AF)
1- Big Pond	livestock, wildlife, recreation, fish life, irrigation	Nov. 1 – June 30	2.59
2- Catfish Pond	livestock, wildlife, recreation, fish life, irrigation	Nov. 1 – June 30	0.65
3- Trout Pond	livestock, wildlife, recreation, fish life, irrigation	Nov. 1 – June 30	0.44
4- Dike Pond	livestock, wildlife, recreation, fish life, irrigation	Nov. 1 – June 30	0.38
5- Orchard Pond	livestock, wildlife, recreation, fish life, irrigation	Nov. 1 – June 30	0.13
Total Quantity of Water Stored			4.19

3. Provide a general narrative description of the distribution works. This description must trace the water system from each point of diversion to the reservoir:

Each of the five ponds are on small seasonal drainage channels and are filled by seasonal run-off. Ponds 1, 2, and 4 are on the same drainage. Pond 4 passes overflow water through an 18" CMP to Pond 1. Pond 1 passes overflow water through an 8" PVC and 18" black corrugated plastic pipe to Pond 2. Pond 2 passes overflow water through an 18" CMP to continue down the drainage. Pond 3 and 5 are on separate drainages. Pond 3 passes overflow through an 18" CMP. Pond 5 passes overflow through an 8" PVC pipe.

Reminder: The map associated with this claim must identify the location of the point(s) of diversion, Donation Land Claims (DLC), Government Lots (GLot), and Quarter-Quarters (QQ).

4. Variations:

Was the use developed differently from what was authorized by the permit,
permit amendment final order, or extension final order? If yes, describe below.

YES

NO

Pond 5 was developed in a different location and with less storage capacity.

5. Claim Summary:

RESERVOIR NAME OR #	MAXIMUM STORAGE AUTHORIZED BY PERMIT (AF)	MAXIMUM STORAGE DEVELOPED (AF)
1- Big Pond	2.59	2.59
2- Catfish Pond	0.65	0.65
3- Trout Pond	0.44	0.44
4- Dike Pond	0.38	0.38
5- Orchard Pond	0.56	0.13

SECTION 4
SYSTEM DESCRIPTION

Are there multiple reservoirs?

☒ YES ☐ NO

If "YES" you will need to copy and complete Sections A through E for each reservoir.

Reservoir Name or Number this section describes (only needed if there is more than one):

1- Big Pond

RECEIVED

JUL 05 2022

A. Reservoir Location

1. Is the reservoir on-channel?

OWRD ☒ YES ☐ NO

2. Provide dam outlet location and/or point of diversion(s).

TWP	RNG	MER	SEC	QQ	GLOT	DLC	MEASURED DISTANCES
13S	1E	WM	22	NENE			*1208' S and 550' W from NE corner, sec. 22
*South measurement from reference corner to dam is consistent with application, but West measurement varies.							

Reminder: The map associated with this claim must identify Donation Land Claims (DLC), Government Lots (GLOT), and Quarter-Quarters (QQ).

B. Diversion and Delivery System Information

Provide the following information concerning the diversion and delivery system. Information provided must describe the equipment used to transport the water from the point(s) of diversion to the reservoir.

1. Is a pump used?

YES ☒ NO

6. Additional notes or comments related to the system:

Pond 1 was constructed on a natural drainage channel and is filled by seasonal run-off.

Vegetation and silt has collected on the bottom of the pond creating a layer that does not allow the sonar to reach the actual bottom. There was a relatively consistent difference between measured depth and applied for (as-built) depth. This correlation was used to confirm the application measurements.

C. Gravity Flow Pipe

(THE DEPARTMENT TYPICALLY USES THE HAZEN-WILLIAM'S FORMULA FOR A GRAVITY FLOW PIPE SYSTEM)

1. Does the system involve a gravity flow pipe?

YES ☒ NO

D. Gravity Flow Canal or Ditch

(THE DEPARTMENT TYPICALLY USES MANNING'S FORMULA FOR CANALS AND DITCHES)

1. Is a gravity flow canal or ditch used to convey the water as part of the distribution system?

YES ☒ NO

E. Reservoir

1. Does the reservoir require the submittal of as-built plans and specifications?

YES ☒ NO

If "YES", answer item 2; items 3 through 8 relating to this section may be deleted.
 If "NO", skip items 2; answer items 3 through 8.

3. If the reservoir stores less than 9.2 acre-feet of water or if the dam is less than 10 feet in height, and as-built plans and specifications are not required, complete the table and items 4 through 8.

MAXIMUM DEPTH	AVERAGE DEPTH	SURFACE AREA (IN ACRES)	VOLUME (IN ACRE FEET)
16.2'	6.48'	0.4	2.59

4. Provide reservoir volume calculations:

6.48(0.4) = 2.59

5. Provide the following information concerning the physical characteristics of the dam:

CREST WIDTH (W)	DAM HEIGHT AT CENTERLINE (H)	DISTANCE FROM DOWNSTREAM TOP OF DAM TO DOWNSTREAM TOE (L)	DISTANCE FROM UPSTREAM TOP OF DAM TO UPSTREAM TOE (U)	WATER LEVEL AT INSPECTION	DOWN-STREAM SLOPE	UP-STREAM SLOPE
14'	24'	27'	21'	1.5' below top of dam	1:1	1:1

6. Provide a drawing showing the cross section of the dam at the maximum section indicating details and dimensions. The drawing should be drawn at a standard even scale.

See attached drawing.

7. Describe the outlet works (size and type of the outlet conduit and location):

The outlet works consist of an 8" PVC pipe located at the far-right side of the dam looking upstream and an 18" corrugated black plastic pipe located at the middle of the dam. (See attached pictures.)

8. Describe the emergency spillway (dimensions and location):

BOTTOM WIDTH (W)	TOP WIDTH (L)	SPILLWAY DEPTH (H)
Application R-87815 was made on existing ponds. The application described Big Pond (Pond 1) as having a 36" W x 27" H concrete emergency spillway with removable slats. During our 6-9-2022 onsite inspection, we found no evidence of the described spillway.		

RECEIVED

JUL 05 2022

OWRD

SECTION 4
SYSTEM DESCRIPTION

Are there multiple reservoirs?

☒ YES ☐ NO

If "YES" you will need to copy and complete Sections A through E for each reservoir.

Reservoir Name or Number this section describes (only needed if there is more than one):

2- Catfish Pond

RECEIVED

JUL 05 2022

A. Reservoir Location

1. Is the reservoir on-channel?

☒ YES ☐ NO
OWRD

2. Provide dam outlet location and/or point of diversion(s).

TWP	RNG	MER	SEC	QQ	GLOT	DLC	MEASURED DISTANCES
13S	1E	WM	22	SENE			*1365' S and 200' W from NE corner, sec. 22
*South measurement from reference corner to dam is consistent with application, but West measurement varies.							

Reminder: The map associated with this claim must identify Donation Land Claims (DLC), Government Lots (GLOT), and Quarter-Quarters (QQ).

B. Diversion and Delivery System Information

Provide the following information concerning the diversion and delivery system. Information provided must describe the equipment used to transport the water from the point(s) of diversion to the reservoir.

1. Is a pump used?

☒ YES ☐ NO

6. Additional notes or comments related to the system:

Pond 2 was constructed on a natural drainage channel and is filled by seasonal run-off.

Vegetation and silt has collected on the bottom of the pond creating a layer that does not allow the sonar to reach the actual bottom. There was a relatively consistent difference between measured depth and applied for (as-built) depth. This correlation was used to confirm the application measurements.

C. Gravity Flow Pipe

(THE DEPARTMENT TYPICALLY USES THE HAZEN-WILLIAM'S FORMULA FOR A GRAVITY FLOW PIPE SYSTEM)

1. Does the system involve a gravity flow pipe?

☒ YES ☐ NO

D. Gravity Flow Canal or Ditch

(THE DEPARTMENT TYPICALLY USES MANNING'S FORMULA FOR CANALS AND DITCHES)

1. Is a gravity flow canal or ditch used to convey the water as part of the distribution system?

☒ YES ☐ NO

E. Reservoir

1. Does the reservoir require the submittal of as-built plans and specifications?

☒ YES ☐ NO

If "YES", answer item 2; items 3 through 8 relating to this section may be deleted.
 If "NO", skip items 2; answer items 3 through 8.

3. If the reservoir stores less than 9.2 acre-feet of water or if the dam is less than 10 feet in height, and as-built plans and specifications are not required, complete the table and items 4 through 8.

MAXIMUM DEPTH	AVERAGE DEPTH	SURFACE AREA (IN ACRES)	VOLUME (IN ACRE FEET)
8.1'	3.25'	0.2	0.65

4. Provide reservoir volume calculations:

$$3.25(0.2) = 0.65$$

5. Provide the following information concerning the physical characteristics of the dam:

CREST WIDTH (W)	DAM HEIGHT AT CENTERLINE (H)	DISTANCE FROM DOWNSTREAM TOP OF DAM TO DOWNSTREAM TOE (L)	DISTANCE FROM UPSTREAM TOP OF DAM TO UPSTREAM TOE (U)	WATER LEVEL AT INSPECTION	DOWN-STREAM SLOPE	UP-STREAM SLOPE
11'	14'	16'	18'	3' below top of dam	1:1	1.5:1

6. Provide a drawing showing the cross section of the dam at the maximum section indicating details and dimensions. The drawing should be drawn at a standard even scale.

See attached drawing.

7. Describe the outlet works (size and type of the outlet conduit and location):

The outlet works consist of an 18" CMP located 8' from the right side of the dam looking upstream. (See attached picture.)

8. Describe the emergency spillway (dimensions and location):

BOTTOM WIDTH (W)	TOP WIDTH (L)	SPILLWAY DEPTH (H)
No spillway found.		

RECEIVED

JUL 05 2022

OWRD

SECTION 4
SYSTEM DESCRIPTION

Are there multiple reservoirs?

☒ YES ☐ NO

If "YES" you will need to copy and complete Sections A through E for each reservoir.

Reservoir Name or Number this section describes (only needed if there is more than one):

RECEIVED

3- Trout Pond

JUL 05 2022

OWRD

A. Reservoir Location

1. Is the reservoir on-channel?

☒ YES ☐ NO

2. Provide dam outlet location and/or point of diversion(s).

TWP	RNG	MER	SEC	QQ	GLOT	DLC	MEASURED DISTANCES
13S	1E	WM	22	NENE			822' S and 428' W from NE corner, sec. 22

Reminder: The map associated with this claim must identify Donation Land Claims (DLC), Government Lots (GLOT), and Quarter-Quarters (QQ).

B. Diversion and Delivery System Information

Provide the following information concerning the diversion and delivery system. Information provided must describe the equipment used to transport the water from the point(s) of diversion to the reservoir.

1. Is a pump used?

YES ☒ NO

6. Additional notes or comments related to the system:

Pond 3 was constructed on a natural drainage channel and is filled by seasonal run-off.

Vegetation and silt has collected on the bottom of the pond creating a layer that does not allow the sonar to reach the actual bottom. There was a relatively consistent difference between measured depth and applied for (as-built) depth. This correlation was used to confirm the application measurements.

C. Gravity Flow Pipe

(THE DEPARTMENT TYPICALLY USES THE HAZEN-WILLIAM'S FORMULA FOR A GRAVITY FLOW PIPE SYSTEM)

1. Does the system involve a gravity flow pipe?

YES ☒ NO

D. Gravity Flow Canal or Ditch

(THE DEPARTMENT TYPICALLY USES MANNING'S FORMULA FOR CANALS AND DITCHES)

1. Is a gravity flow canal or ditch used to convey the water as part of the distribution system?

YES ☒ NO

E. Reservoir

1. Does the reservoir require the submittal of as-built plans and specifications?

YES ☒ NO

If "YES", answer item 2; items 3 through 8 relating to this section may be deleted.
 If "NO", skip items 2; answer items 3 through 8.

3. If the reservoir stores less than 9.2 acre-feet of water or if the dam is less than 10 feet in height, and as-built plans and specifications are not required, complete the table and items 4 through 8.

MAXIMUM DEPTH	AVERAGE DEPTH	SURFACE AREA (IN ACRES)	VOLUME (IN ACRE FEET)
7.3'	2.9'	0.15	0.44

4. Provide reservoir volume calculations:

2.9(0.15) = 0.44

5. Provide the following information concerning the physical characteristics of the dam:

CREST WIDTH (W)	DAM HEIGHT AT CENTERLINE (H)	DISTANCE FROM DOWNSTREAM TOP OF DAM TO DOWNSTREAM TOE (L)	DISTANCE FROM UPSTREAM TOP OF DAM TO UPSTREAM TOE (U)	WATER LEVEL AT INSPECTION	DOWN-STREAM SLOPE	UP-STREAM SLOPE
8'	16'	18'	8'	2' below top of dam	1:1	0.5:1

6. Provide a drawing showing the cross section of the dam at the maximum section indicating details and dimensions. The drawing should be drawn at a standard even scale.

See attached drawing.

7. Describe the outlet works (size and type of the outlet conduit and location):

The outlet works consist of an 18" CMP located 10' from the right side of the dam looking upstream. (See attached picture.)

8. Describe the emergency spillway (dimensions and location):

BOTTOM WIDTH (W)	TOP WIDTH (L)	SPILLWAY DEPTH (H)
No spillway found.		

RECEIVED

JUL 05 2022

OWRD

SECTION 4
SYSTEM DESCRIPTION

Are there multiple reservoirs?

☒ YES ☐ NO

If "YES" you will need to copy and complete Sections A through E for each reservoir.

Reservoir Name or Number this section describes (only needed if there is more than one):

4- Dike Pond

A. Reservoir Location

1. Is the reservoir on-channel?

☒ YES ☐ NO

2. Provide dam outlet location and/or point of diversion(s).

TWP	RNG	MER	SEC	QQ	GLOT	DLC	MEASURED DISTANCES
13S	1E	WM	22	NENE			1073' S and 796' W from NE corner, sec. 22

Reminder: The map associated with this claim must identify Donation Land Claims (DLC), Government Lots (GLOT), and Quarter-Quarters (QQ).

RECEIVED

JUL 05 2022

B. Diversion and Delivery System Information

Provide the following information concerning the diversion and delivery system. Information provided must describe the equipment used to transport the water from the point(s) of diversion to the reservoir.

OWRD

1. Is a pump used?

YES ☒ NO

6. Additional notes or comments related to the system:

Pond 4 was constructed on a natural drainage channel and is filled by seasonal run-off.

Vegetation and silt has collected on the bottom of the pond creating a layer that does not allow the sonar to reach the actual bottom. There was a relatively consistent difference between measured depth and applied for (as-built) depth. This correlation was used to confirm the application measurements.

C. Gravity Flow Pipe

(THE DEPARTMENT TYPICALLY USES THE HAZEN-WILLIAM'S FORMULA FOR A GRAVITY FLOW PIPE SYSTEM)

1. Does the system involve a gravity flow pipe?

YES ☒ NO

D. Gravity Flow Canal or Ditch

(THE DEPARTMENT TYPICALLY USES MANNING'S FORMULA FOR CANALS AND DITCHES)

1. Is a gravity flow canal or ditch used to convey the water as part of the distribution system?

YES ☒ NO

E. Reservoir

1. Does the reservoir require the submittal of as-built plans and specifications?

YES ☒ NO

If "YES", answer item 2; items 3 through 8 relating to this section may be deleted.

If "NO", skip items 2; answer items 3 through 8.

3. If the reservoir stores less than 9.2 acre-feet of water or if the dam is less than 10 feet in height, and as-built plans and specifications are not required, complete the table and items 4 through 8.

MAXIMUM DEPTH	AVERAGE DEPTH	SURFACE AREA (IN ACRES)	VOLUME (IN ACRE FEET)
6.4'	2.5'	0.15	0.38

4. Provide reservoir volume calculations:

$$2.5(0.15) = 0.38$$

5. Provide the following information concerning the physical characteristics of the dam:

CREST WIDTH (W)	DAM HEIGHT AT CENTERLINE (H)	DISTANCE FROM DOWNSTREAM TOP OF DAM TO DOWNSTREAM TOE (L)	DISTANCE FROM UPSTREAM TOP OF DAM TO UPSTREAM TOE (U)	WATER LEVEL AT INSPECTION	DOWN-STREAM SLOPE	UP-STREAM SLOPE
10'	16'	18.5'	14'	5.4' below top of dam	1:1	1:1

6. Provide a drawing showing the cross section of the dam at the maximum section indicating details and dimensions. The drawing should be drawn at a standard even scale.

See attached drawing.

7. Describe the outlet works (size and type of the outlet conduit and location):

The outlet works consist of an 18" CMP located at the middle of the dam. (See attached picture.)

8. Describe the emergency spillway (dimensions and location):

BOTTOM WIDTH (W)	TOP WIDTH (L)	SPILLWAY DEPTH (H)
No spillway found.		

RECEIVED

JUL 05 2022

OWRD

SECTION 4

SYSTEM DESCRIPTION

Are there multiple reservoirs?

☒ YES ☐ NO

If "YES" you will need to copy and complete Sections A through E for each reservoir.

Reservoir Name or Number this section describes (only needed if there is more than one):

5- Orchard Pond

RECEIVED

JUL 05 2022

A. Reservoir Location

1. Is the reservoir on-channel?

OWRD

☒ YES ☐ NO

2. Provide dam outlet location and/or point of diversion(s).

TWP	RNG	MER	SEC	QQ	GLOT	DLC	MEASURED DISTANCES
13S	1E	WM	22	NENE			*1240' S and 880' W from NE corner, sec. 22
*No dam, measured to center of pond.							

Reminder: The map associated with this claim must identify Donation Land Claims (DLC), Government Lots (GLOT), and Quarter-Quarters (QQ).

B. Diversion and Delivery System Information

Provide the following information concerning the diversion and delivery system. Information provided must describe the equipment used to transport the water from the point(s) of diversion to the reservoir.

1. Is a pump used?

☒ YES ☐ NO

6. Additional notes or comments related to the system:

Application R-87815 shows Pond 5 on the same small channel and just below Pond 3. On the 6-9-2022 onsite inspection, a pond was not found at this location. The owner, Ann Leschen, said that she has also not been able to find a pond at this location. She did direct us to a small dug pond with no dam of similar depth. This pond is being claimed as Pond 5. It is also filled with seasonal run-off.

C. Gravity Flow Pipe

(THE DEPARTMENT TYPICALLY USES THE HAZEN-WILLIAM'S FORMULA FOR A GRAVITY FLOW PIPE SYSTEM)

1. Does the system involve a gravity flow pipe?

☒ YES ☐ NO

D. Gravity Flow Canal or Ditch

(THE DEPARTMENT TYPICALLY USES MANNING'S FORMULA FOR CANALS AND DITCHES)

1. Is a gravity flow canal or ditch used to convey the water as part of the distribution system?

☒ YES ☐ NO

E. Reservoir

1. Does the reservoir require the submittal of as-built plans and specifications?

☒ YES ☐ NO

If "YES", answer item 2; items 3 through 8 relating to this section may be deleted.
If "NO", skip items 2; answer items 3 through 8.

3. If the reservoir stores less than 9.2 acre-feet of water or if the dam is less than 10 feet in height, and as-built plans and specifications are not required, complete the table and items 4 through 8.

MAXIMUM DEPTH	AVERAGE DEPTH	SURFACE AREA (IN ACRES)	VOLUME (IN ACRE FEET)
2.9'	2.6'	0.05	0.13

4. Provide reservoir volume calculations:

$$2.6(0.05) = 0.13$$

5. Provide the following information concerning the physical characteristics of the dam:

CREST WIDTH (W)	DAM HEIGHT AT CENTERLINE (H)	DISTANCE FROM DOWNSTREAM TOP OF DAM TO DOWNSTREAM TOE (L)	DISTANCE FROM UPSTREAM TOP OF DAM TO UPSTREAM TOE (U)	WATER LEVEL AT INSPECTION	DOWN-STREAM SLOPE	UP-STREAM SLOPE
--------------------	------------------------------------	--	--	------------------------------	----------------------	--------------------

Dug pond with no dam.

6. Provide a drawing showing the cross section of the dam at the maximum section indicating details and dimensions. The drawing should be drawn at a standard even scale.

Dug pond with no dam.

7. Describe the outlet works (size and type of the outlet conduit and location):

The outlet works consist of an 8" PVC outlet pipe located 7' from the right edge of the pond looking upstream.

8. Describe the emergency spillway (dimensions and location):

BOTTOM WIDTH (W)	TOP WIDTH (L)	SPILLWAY DEPTH (H)
No spillway.		

RECEIVED
JUL 05 2022
OWRD

SECTION 5 CONDITIONS

OWRD

All conditions contained in the permit, permit amendment, or any extension final order shall be addressed. Reports that do not address all performance related conditions will be returned.

1. Time Limits:

Permits and any extension final orders contain any or all of the following dates; the date when the actual construction work was to begin, the date when the construction was to be completed, and the date when the complete application of water to the proposed was to be completed. These dates may be referred to as ABC dates. Describe how the water user has complied with each of the development timelines established in the permit or extension final order:

	DATE FROM PERMIT	DATE ACCOMPLISHED*	DESCRIPTION OF ACTIONS TAKEN BY WATER USER TO COMPLY WITH THE TIME LIMITS
ISSUANCE DATE	2-7-2013		
BEGIN CONSTRUCTION (A)	2-7-2018	*	* Application R-87815 was made on existing ponds constructed around the year 1999.
COMPLETE CONSTRUCTION (B)	2-7-2018	*	
COMPLETE APPLICATION OF WATER (C)	2-7-2018	*	

* must be within period between permit or any extension final order issuance and the date to completely apply water

2. Is there an extension final order(s)?

YES ☒ NO ☐

3. Measurement Conditions:

a. Does the permit, permit amendment, or any extension final order require the installation of a meter or approved measuring device?

YES ☒ NO ☐

4. Recording and reporting conditions

a. Is the water user required to report the water use to the Department?

YES ☒ NO ☐

5. Outlet Pipe

a. Is the water user required to install a minimum 8" outlet pipe/conduit?

☒ YES ☐ NO

If "NO", items b through c relating to this section may be deleted.

b. Has the outlet pipe been installed?

☒ YES ☐ NO

6. Fish Screening

a. Are any points of diversion required to be screened to prevent fish from entering the point of diversion?

YES ☒ NO ☐

7. By-pass Devices

a. Are any points of diversion required to have a by-pass device to prevent fish from entering the point of diversion?

YES ☒ NO ☐

8. Other conditions required by permit, permit amendment final order, or extension final order

- | | | |
|---|---|-----------------------------|
| a. Was the water user required to restore the riparian area if it was disturbed? | ☒ YES | ☐ NO |
| b. Was a fishway required? | ☒ YES | ☐ NO |
| c. Was submittal of a letter from an engineer required prior to storage of water? | ☒ YES | ☐ NO |
| d. Was submittal of a water management and conservation plan required? | ☒ YES | ☐ NO |
| e. Other conditions? | ☒ YES | ☐ NO |

If "YES" to any of the above, identify the condition and describe the water user's actions to comply with the condition(s):

According to Application R-87815, these ponds were built around 1999 by a previous owner. At the time of the COBU onsite inspection, there were no disturbed riparian areas. The ponds were so overgrown with brush that it made it difficult to get measurements (see attached pictures).

SECTION 6

ATTACHMENTS

Provide a list of any additional documents you are attaching to this report:

ATTACHMENT NAME	DESCRIPTION
Pictures (x15)	Taken at 6-9-2022 onsite inspection.
Drawings (x4)	Dam profiles for Ponds 1-4.
Scan	Big Pond (Pond 1) sonar scan showing survey method. Other ponds too small for data to sync properly.

RECEIVED

JUL 05 2022

OWRD

SECTION 7

CLAIM OF BENEFICIAL USE MAP

REC-720

JUL 05 2022

07/05/2022

The Claim of Beneficial Use Map must be submitted with this claim. Claims submitted without the Claim of Beneficial Use map will be returned. The map shall be submitted on poly film at a scale of 1" = 1320 feet, 1" = 400 feet, or the original full-size scale of the county assessor map for the location.

Provide a general description of the survey method used to prepare the map. Examples of possible methods include, but are not limited to, a traverse survey, GPS, or the use of aerial photos. If the basis of the survey is an aerial photo, provide the source, date, series and the aerial photo identification number.

Survey method used was aerial photo provided by Maxar Technologies. Owner confirmed that she has not made changes to ponds after the C date.

Source Date: 8-24-2021

Deeper Sonar device used to confirm pond depths.

Measurements taken on 6-9-2022

Map Checklist

RECEIVED

JUL 05 2022

OWRD

Please be sure that the map you submit includes ALL the items listed below.

(Reminder: Incomplete maps and/or claims may be returned.)

- ☒ Map on polyester film.
- ☒ Appropriate scale (1" = 400 feet, 1" = 1320 feet, or the original full-size scale of the county assessor map)
- ☒ Township, Range, Section, Donation Land Claims, and Government Lots
- ☒ N/A If irrigation, number of acres irrigated within each projected Donation Land Claims, Government Lots, Quarter-Quarters
- ☒ N/A Locations of fish screens and/or fish by-pass devices in relationship to point of diversion
- ☒ N/A Locations of meters and/or measuring devices in relationship to point of diversion
- ☒ N/A Conveyance structures illustrated (pumps, reservoirs, pipelines, ditches, etc.)
- ☒ N/A Point(s) of diversion or appropriation (illustrated and coordinates)
- ☒ Tax lot boundaries and numbers
- ☒ Source illustrated if surface water
- ☒ Disclaimer ("This map is not intended to provide legal dimensions or locations of property ownership lines")
- ☒ Application and permit number or transfer number
- ☒ North arrow
- ☒ Legend
- ☒ CWRE stamp and signature



RECEIVED
JUL 05 2022
OWRD

6/9/22 onsite - Leschen COBU
Pond 2 dam



RECEIVED

JUL 05 2022

OWRD

6/9/22 onsite - Leschen COBU
pond 2



RECEIVED

JUL 05 2022

OWRD

6/9/22 onsite

Leschen COBU

pond 2 outlet pipe



RECEIVED

JUL 05 2022

OWRD

6/9/22 onsite - Leschen COBU
pond 1 dam



RECEIVED

JUL 05 2022

OWRD

6/7/22 onsite - Leschen LOBU
pond 1

5



6/9/22 onsite

Leschen COBU

pond 1 outlet pipe #1

RECEIVED

JUL 05 2022

OWRD



RECEIVED

JUL 05 2022

OWRD

6/9/22 onsite
Leschen COBU
pond 1 outlet pipe #2



RECEIVED

JUL 05 2022

OWRD

6/9/22 onsite - Leschen COBU
pond 3 dam



RECEIVED

JUL 05 2022

OWBD

6/9/22 onsite - Leschen COBU
pond 3

(9)



RECEIVED

JUL 05 2022

OWRD

6/9/22 onsite

Leschen COBU

pond 3 outlet pipe



RECEIVED

JUL 05 2022

OWRD

6/9/22 onsite - Leschen COBU
pond 4 dam



RECEIVED

JUL 05 2022

OWRD

6/9/22 onsite - Leschen COBU
pond 4

(12)



RECEIVED

JUL 05 2022

OWRD

6/1/22 onsite

Leschen COBU

pand 4 outlet pipe



RECEIVED
JUL 05 2022
OWRD

6/9/22 onsite - Leschen CoBU
pond 5



RECEIVED

JUL 05 2022


OWRD

6/9/22 onsite
Leschen COBU
pond 5 outlet pipe

Pond 1 Dam Profile

Scale = 1" = 10' Vert. & Horz.

Dam

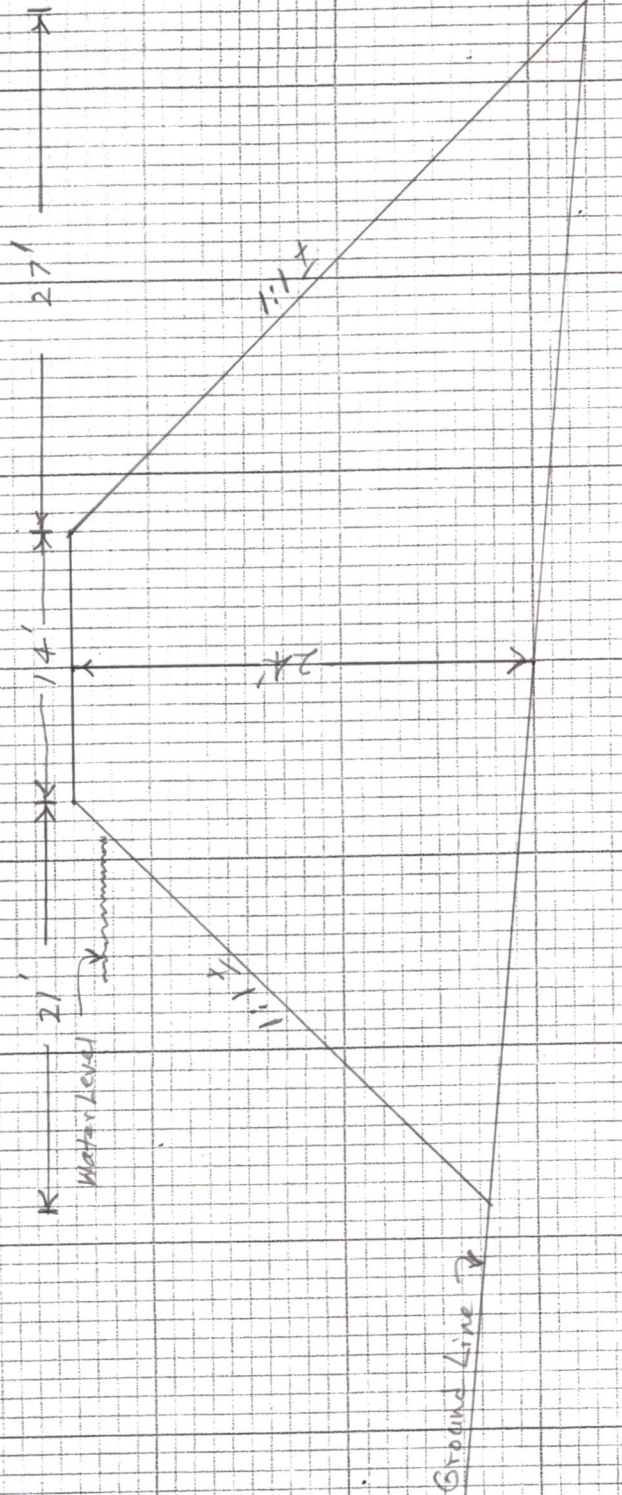

RECEIVED


JUL 05 2022

OWRD

Pond 2 Dam Profile

Scale = 1" = 10' Vert. & Horiz.


Dam

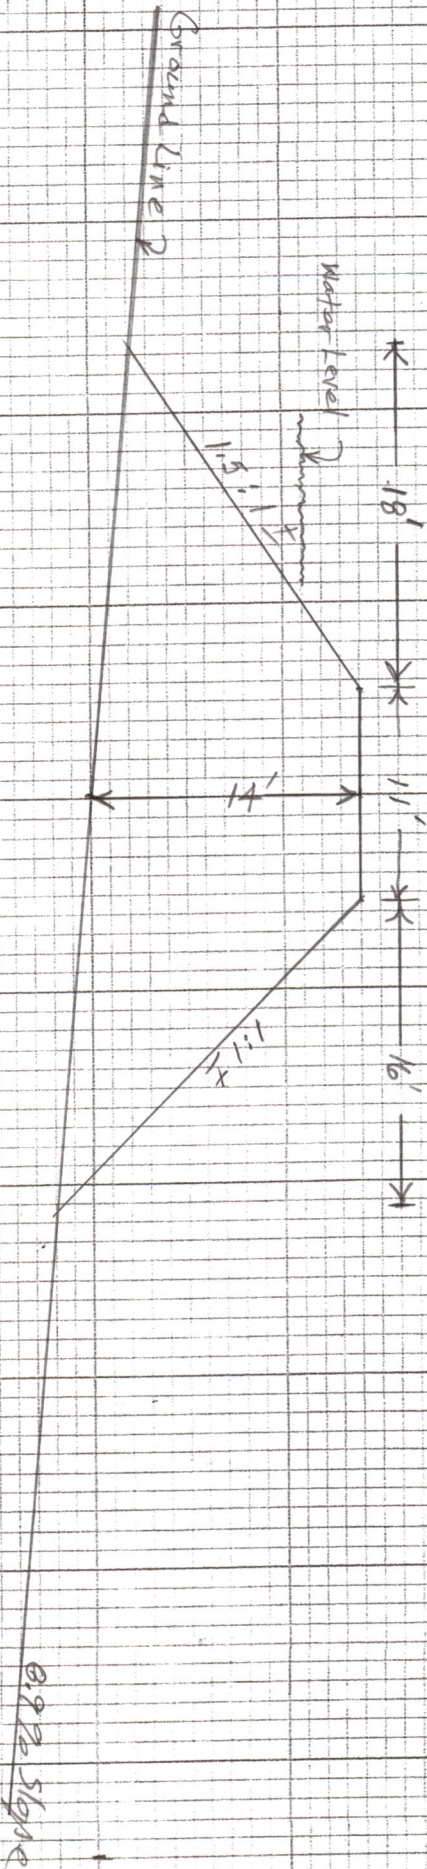

RECEIVED
JUL 05 2022
OWRD

Pond 3 Dam Profile

Scale = 1" = 10' Vert. & Horiz.

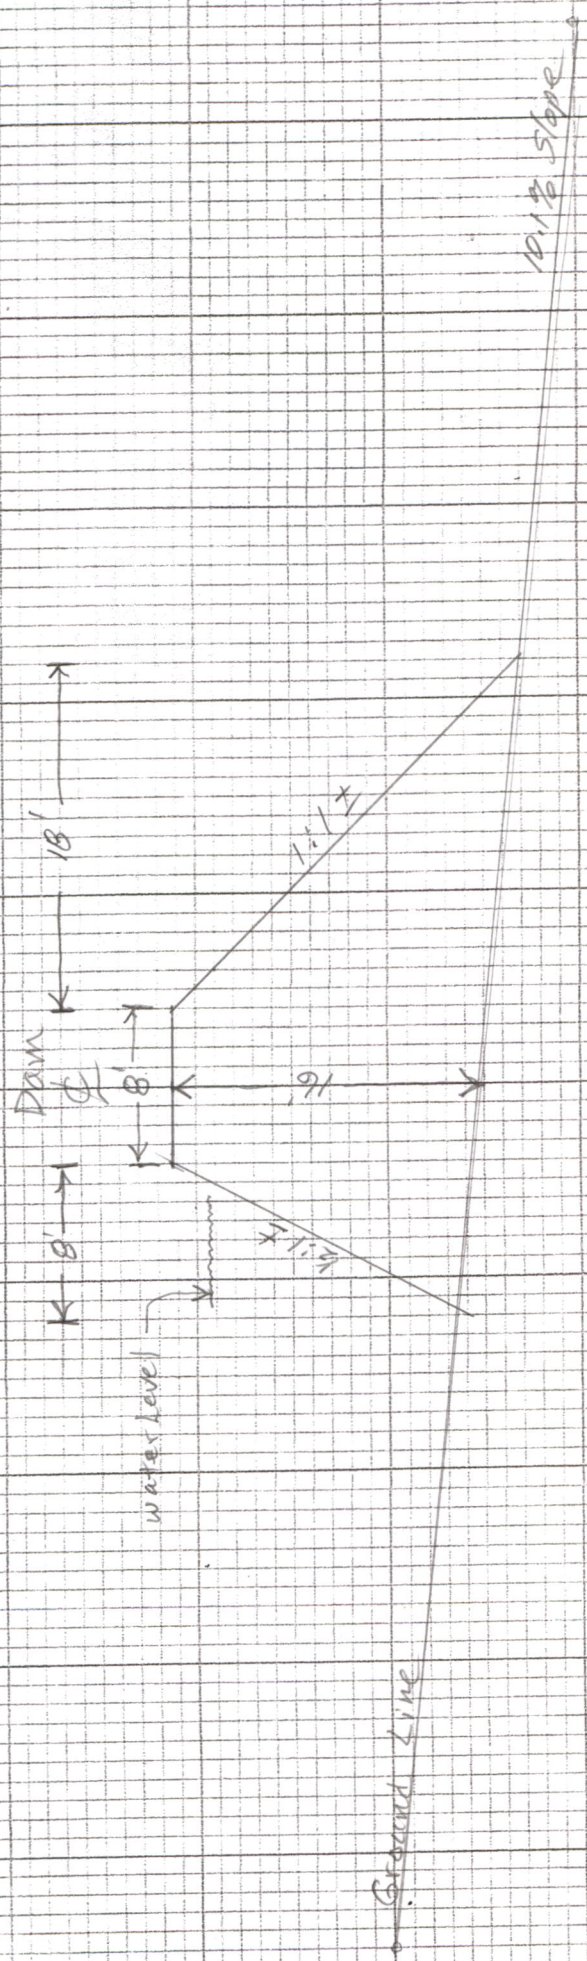


RECEIVED

JUL 05 2022

OWRD

Pond & Dam Profile

Scale = 1" = 10' Vert & Horiz

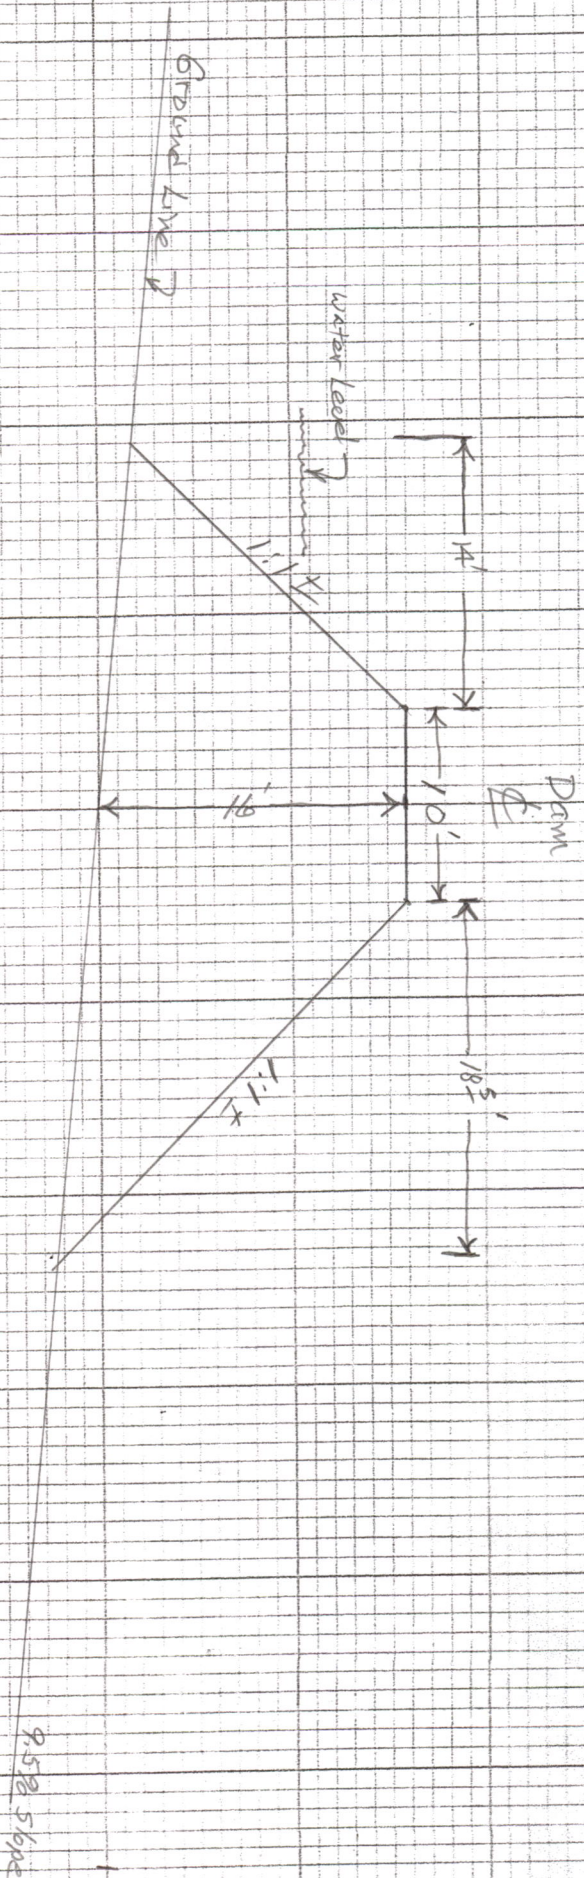

RECEIVED
JUL 05 2022
OWRD

RECEIVED

JUL 05 2022

OWRD

SCAN – Big Pond (Pond 1) – Permit R-15003

Measured Maximum Depth = 14.3' Built Depth = 16.2'

