



|    |
|----|
| C2 |
| C3 |
| C4 |
| C5 |
| C6 |
| C7 |
| C8 |

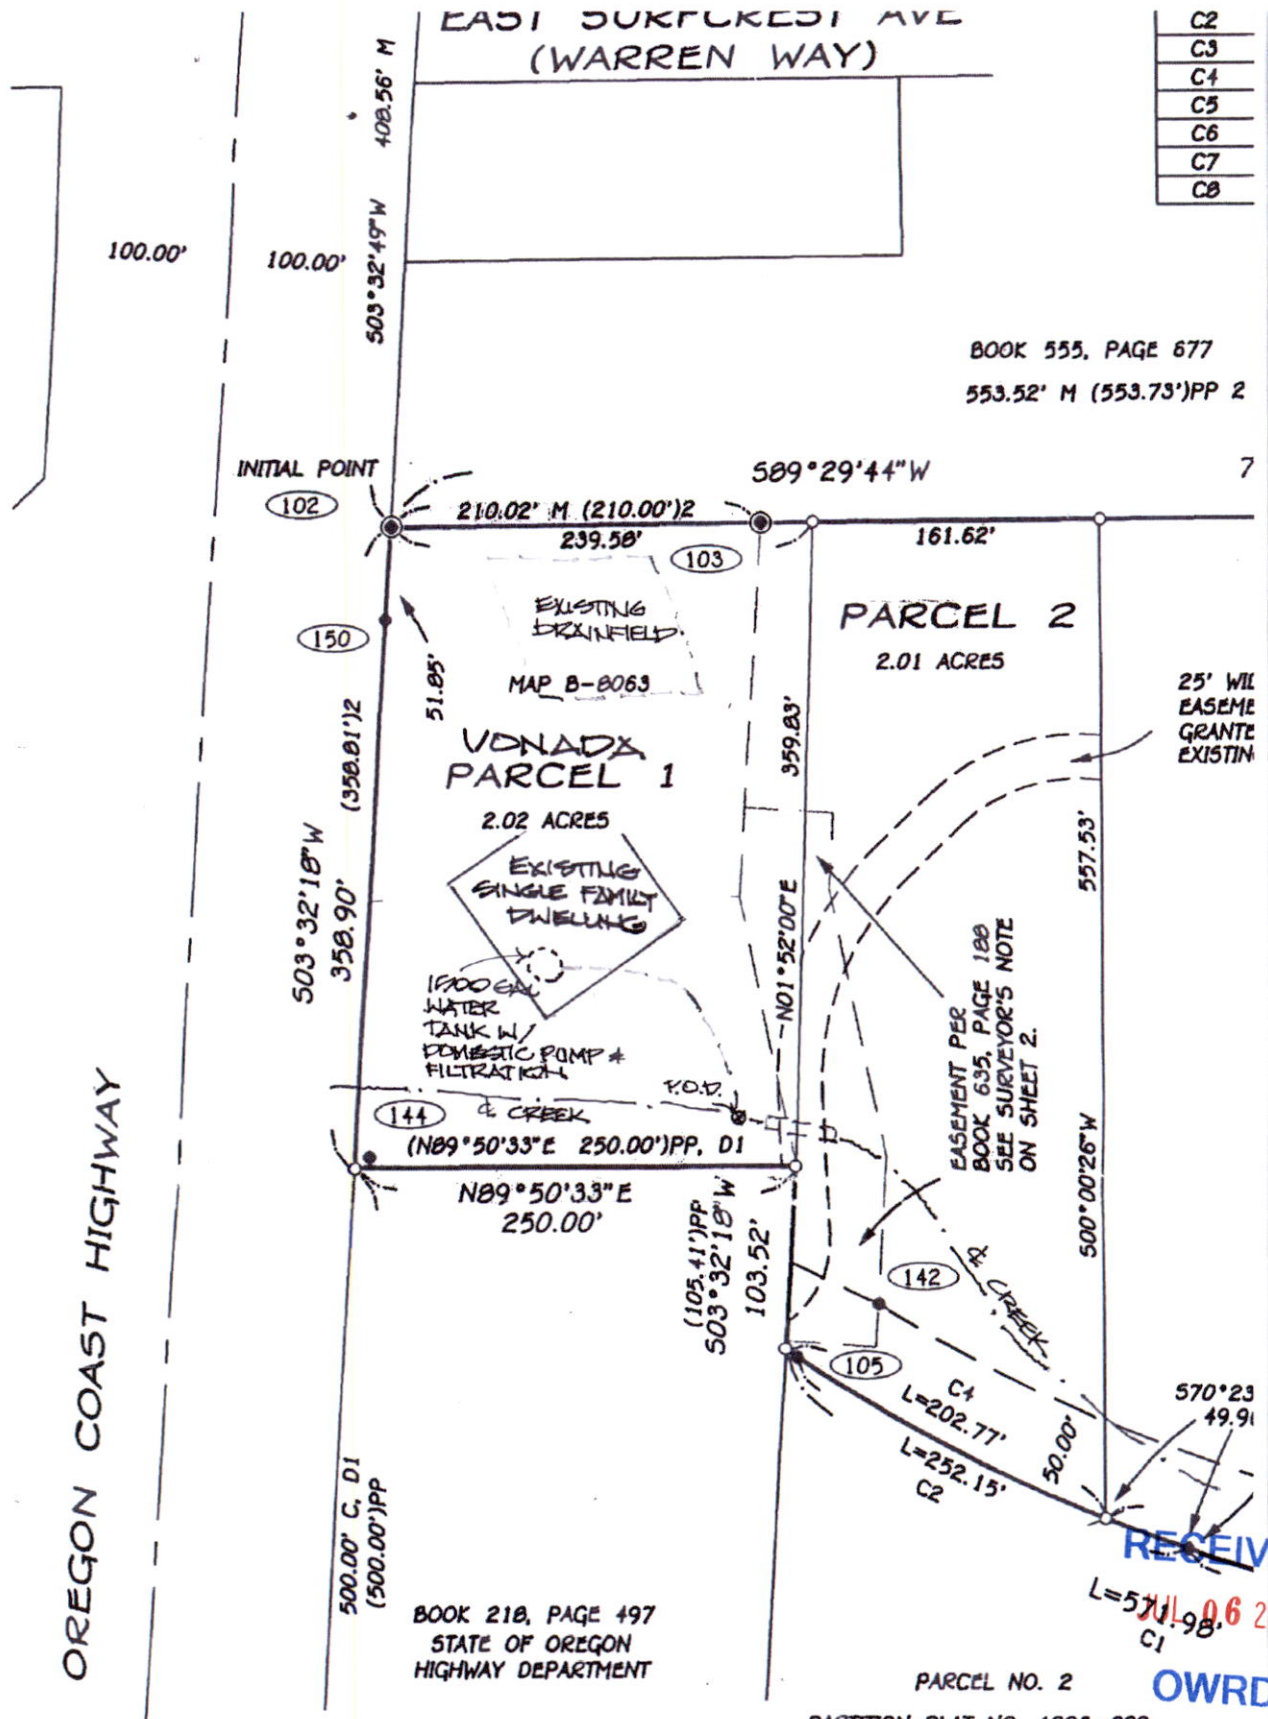

**RECEIVED**  
JUL 06 2022  
OWRD

**VONADA RESIDENCE**  
**SITE PLAN**  
NO SCALE  
7-06-22

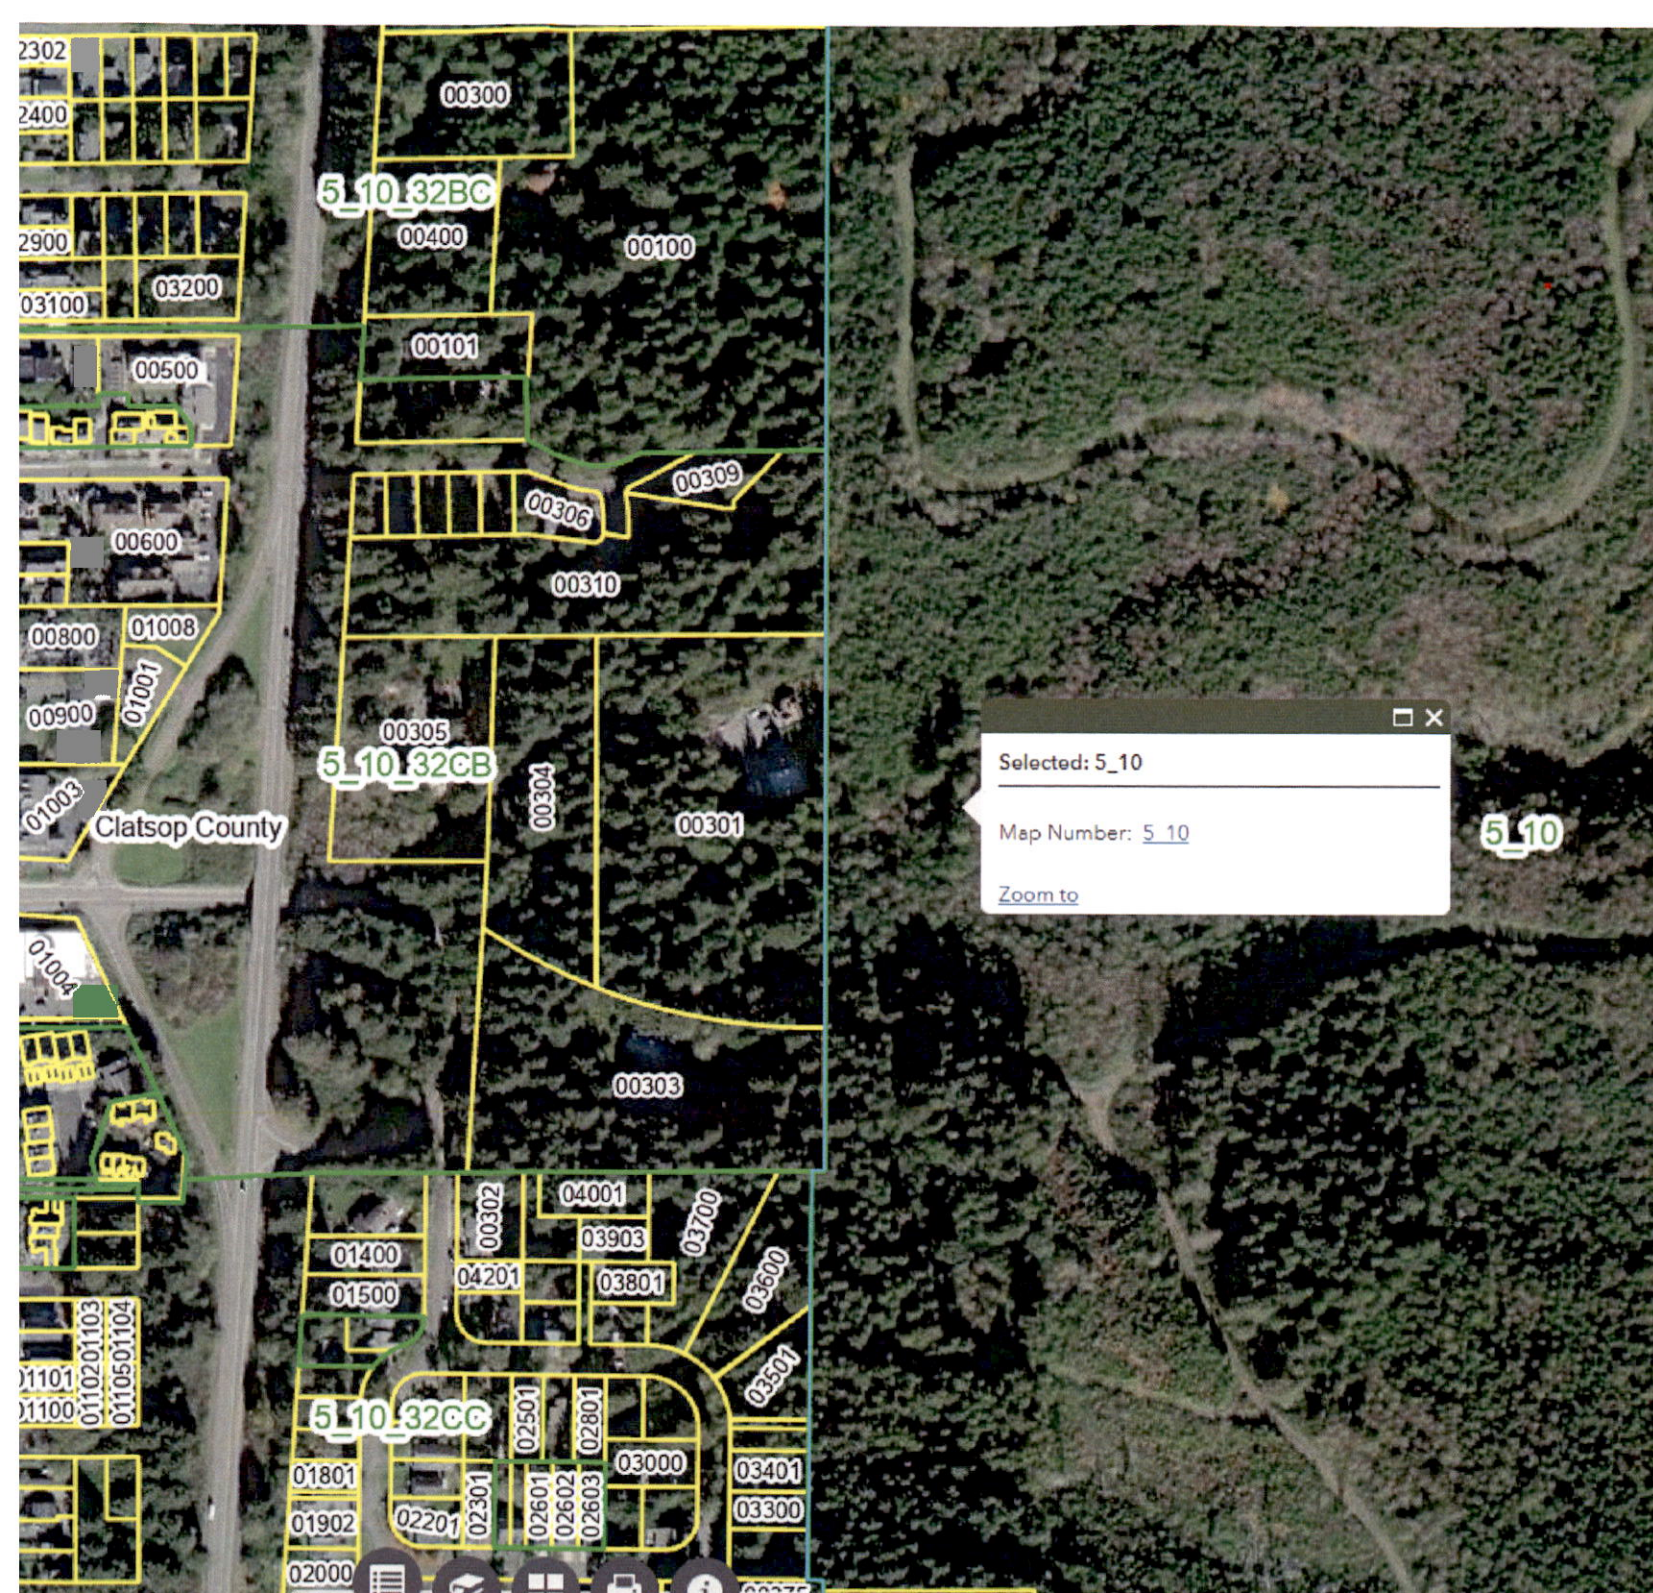

☐ ✕

Selected: 5\_10

Map Number: [5\\_10](#)

[Zoom to](#)