

CLAIM OF BENEFICIAL USE AND SITE REPORT
LOCATED IN THE SW¼ SE¼ OF SECTION 7
TOWNSHIP 23 SOUTH, RANGE 12 WEST, W.M.
COOS COUNTY, OREGON



APPLICATION R-73882 PERMIT R-12243

PREPARED FOR: AL JENSEN
PREPARED BY: DENNIS GOUDE
DATE PREPARED: SEPTEMBER 9, 2004

NOTE:
P.O.D. 1 IS LOCATED 499.9 FEET NORTH
AND 8.7 FEET WEST AND P.O.D. 2 IS
LOCATED 588.8 FEET NORTH AND 61.8 FEET
WEST OF THE EAST 1/16 CORNER OF SECTION 7

NOTE:
P.O.D. 1 & P.O.D. 2 ARE IN CHANNEL RESERVOIRS
CONSTRUCTED FOR WETLAND USE.

Scale 1"=400'

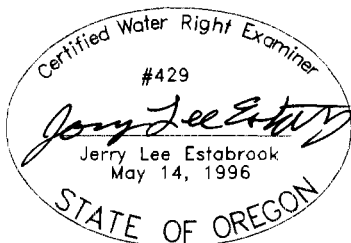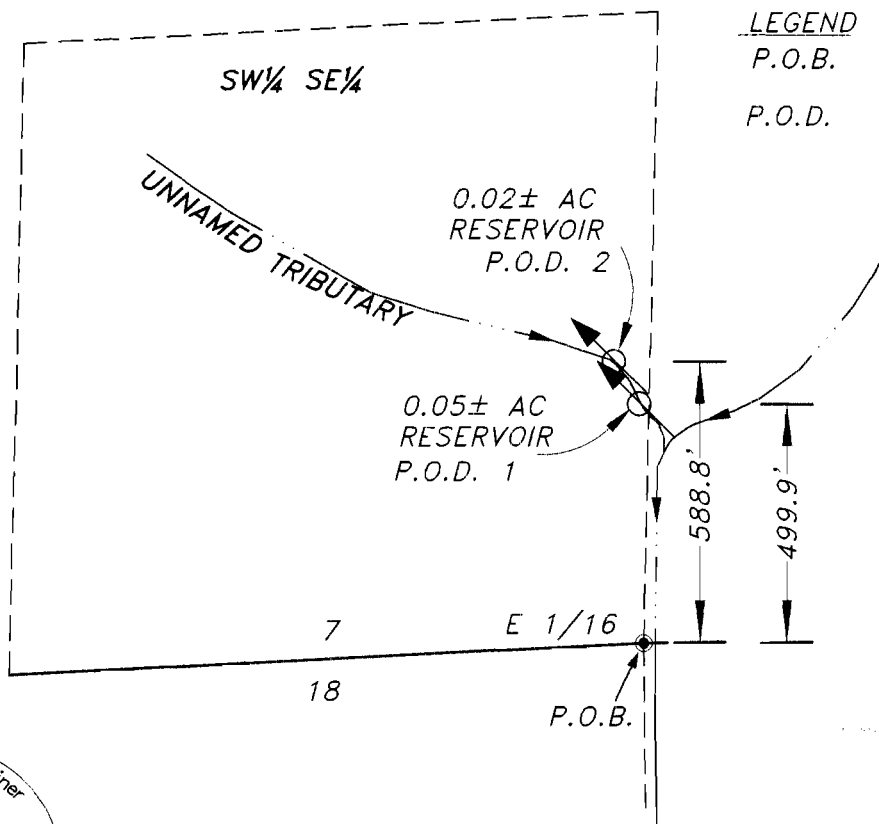

EXPIRES 12/31/2005

EXAMINERS DISCLAIMER STATEMENT

The preparation of this map was for the purpose of identifying the location of the Water Right only and has no intent to provide dimensions or location of property ownership lines.

Stuntzner Engineering
& Forestry, L.L.C.

ENGINEERING • LAND SURVEYING • FORESTRY
PLANNING • WATER RIGHTS

705 South 4th St.
Post Office Box 118
Coos Bay, Oregon 97420

Phone: (541) 267-2872
Fax: (541) 267-0588