

079-04

99.93 AC.S


RECEIVED
JUL 13 2022
OWRD

RECEIVED
JUN 27 2022
OWRD

401

Reservoir Application Erica Shetzline

Township 15 S. Range 1 W., Section 28, SW SE, Tax Lot 804

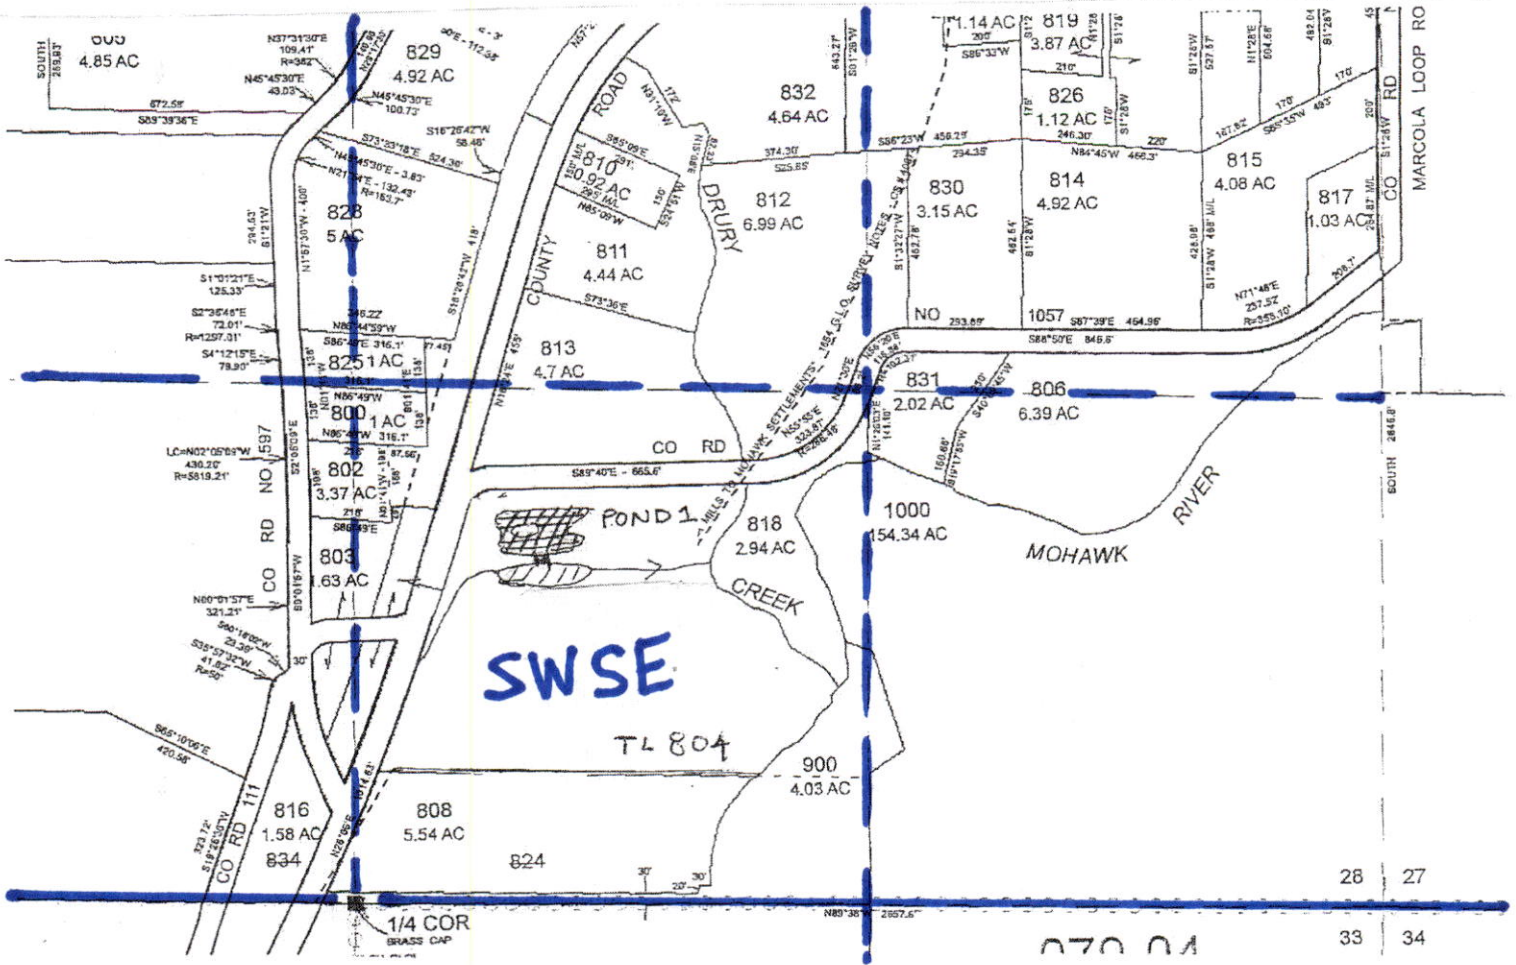

1" = 500'

Center of Pond 1: 967 feet North and 472 feet East from the reference corner
(44.232317, -122.813050)

RECEIVED

JUL 13 2022

OWRD

RECEIVED

JUN 27 2022

OWRD

Reference Corner: South 1/4 Corner