


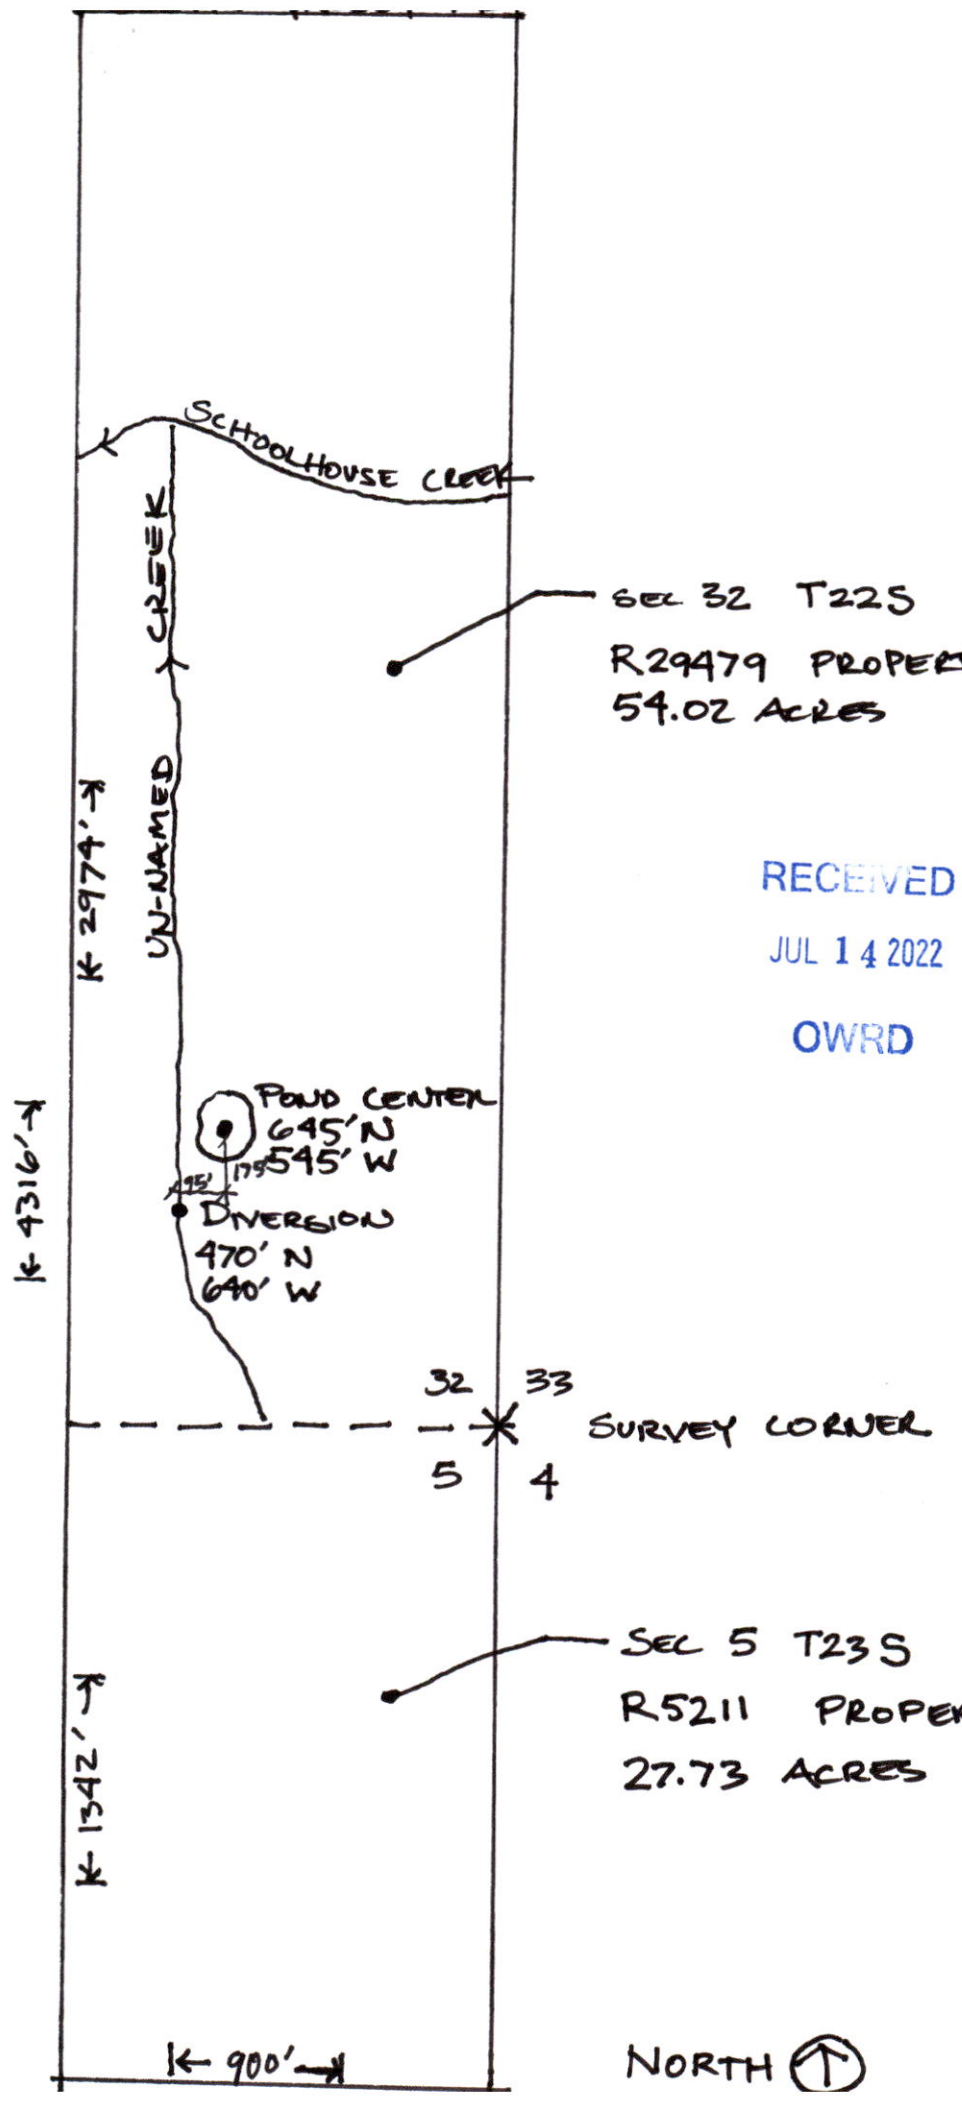

SEC 32 T22S R4W WM
R29479 PROPERTY TAX #
54.02 ACRES

RECEIVED
JUL 14 2022
OWRD

SEC 5 T23S R4W WM
R5211 PROPERTY TAX #
27.73 ACRES

NORTH ↑ 1"=400'