


T. 6S., R. 39E., W.M.

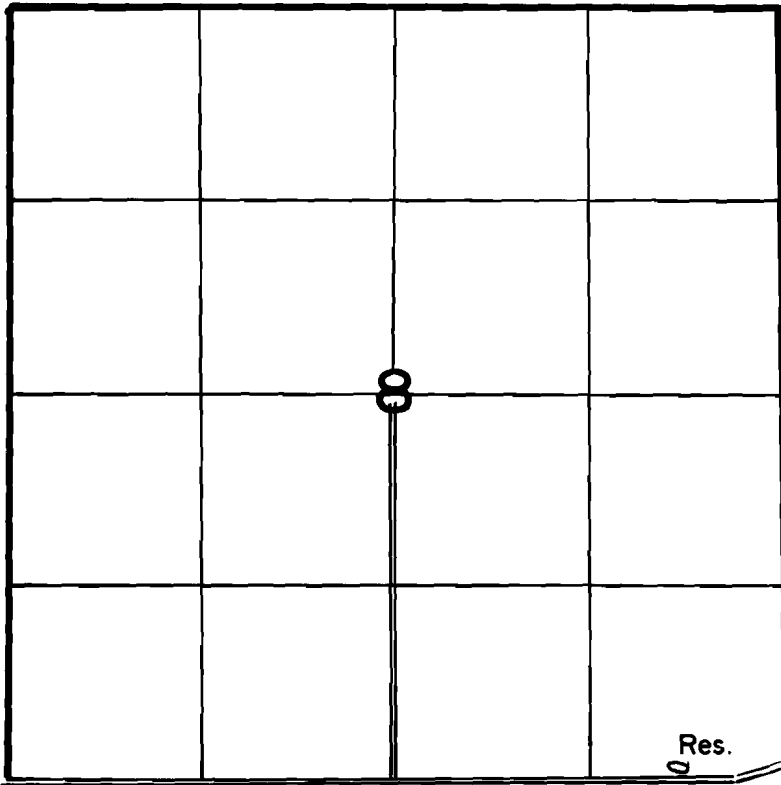

Scale 1" = 1320'


The purpose of this map is for identifying the location of the water right only and is not intended to provide legal dimensions of property ownership lines

FINAL PROOF SURVEY UNDER

APPL. R-73952 PER. R-11592
IN NAME OF

GERALD GRAY

SURVEYED SEPT. 28, 1999

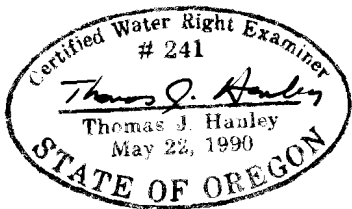

RECEIVED

OCT 01 1999
WATER RESOURCES DEPT
SALEM, OREGON