

T. 16 S. R. 3 W. W. M. "CLAIM OF BENEFICIAL USE" FINAL PROOF SURVEY UNDER

PERMIT NO. R-11666 FILE NO. R-73998

IN NAME OF

RICHARD K. & JESSIE LEE BYLUND

SURVEYED NOVEMBER 20, 2000

BY CHARLES W. GUILLE

PRIORITY DATE
APRIL 7, 1994

"V" = AIR VEHT


X = 12" PIPE W/GATE

FUTURE RESERVOIR (RICE PADDIES)

LWSE 6.1 AC. TOTAL
SWSE 2.6 AC.
SESW 0.3 AC.
NESW 0.6 AC.
SWHE 1.0 AC.

RESERVOIR (RICE PADDIES)


NESW 0.7 AC.
SESW 1.4 AC.
LWSE 12.4 AC.
SWSE 16.0 AC.

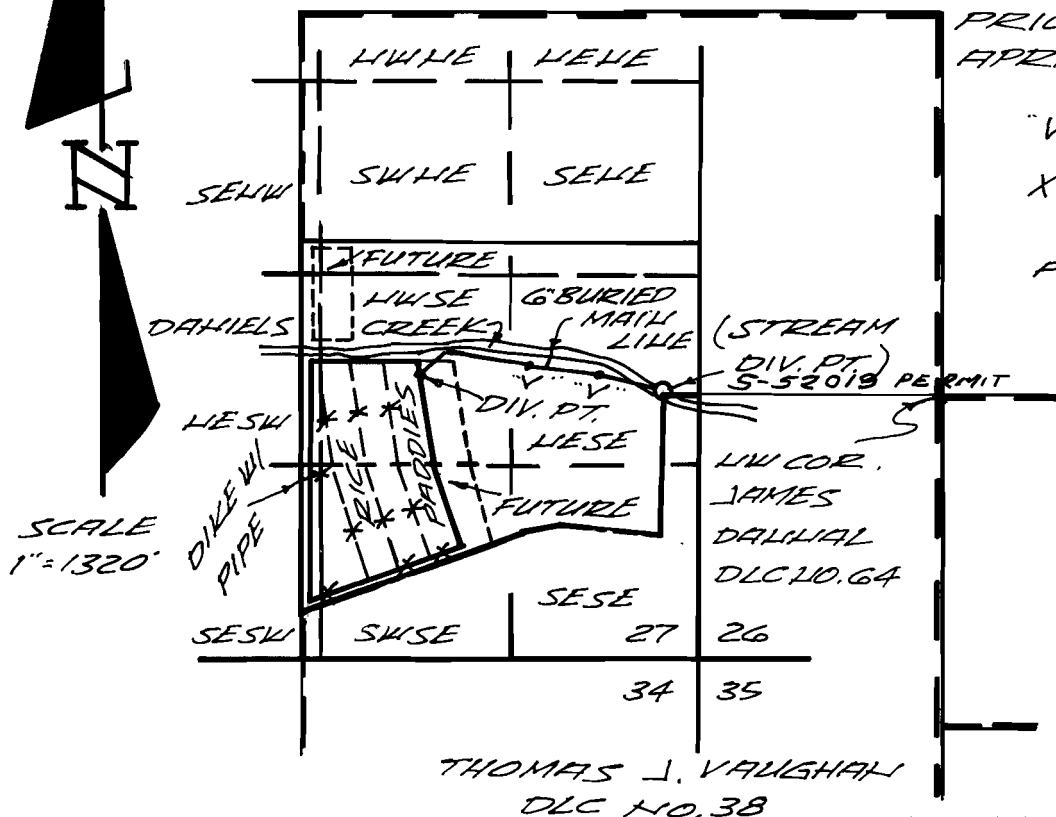

RESERVOIR POINT OF DIVERSON
176.0 FEET NORTH AND 3397.0 FEET
WEST OF LW COR. DLC NO. 64

STREAM POINT OF DIVERSON
26.0 FEET NORTH AND 1925.0
WEST OF THE LW COR. DLC.
NO. 64

THIS MAP IS FOR WATER RIGHT
PURPOSE ONLY AND IS NOT
INTENDED TO PROVIDE
DIMENSIONS FOR LOCATING
PROPERTY BOUNDARIES

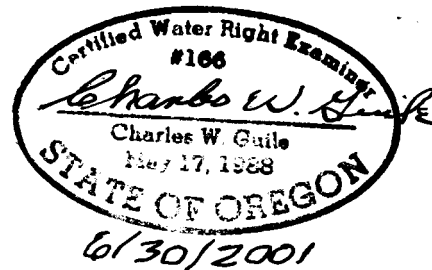

CHARLES W. GUILLE
& ASSOCIATES, CO.
Land Surveying
52 Centennial Loop
Eugene, OR 97401

2000-21