


SECTION 30 T.15., R.3W., W.M.  
WASHINGTON COUNTY, OREGON

RECEIVED

SEP 16 1993

WATER RESOURCES DEPT.  
SALEM, OREGON

TALON & LISA BUCHHOLZ  
41840 S.W. VANDEHEY RD.  
GASTON, OR 97119

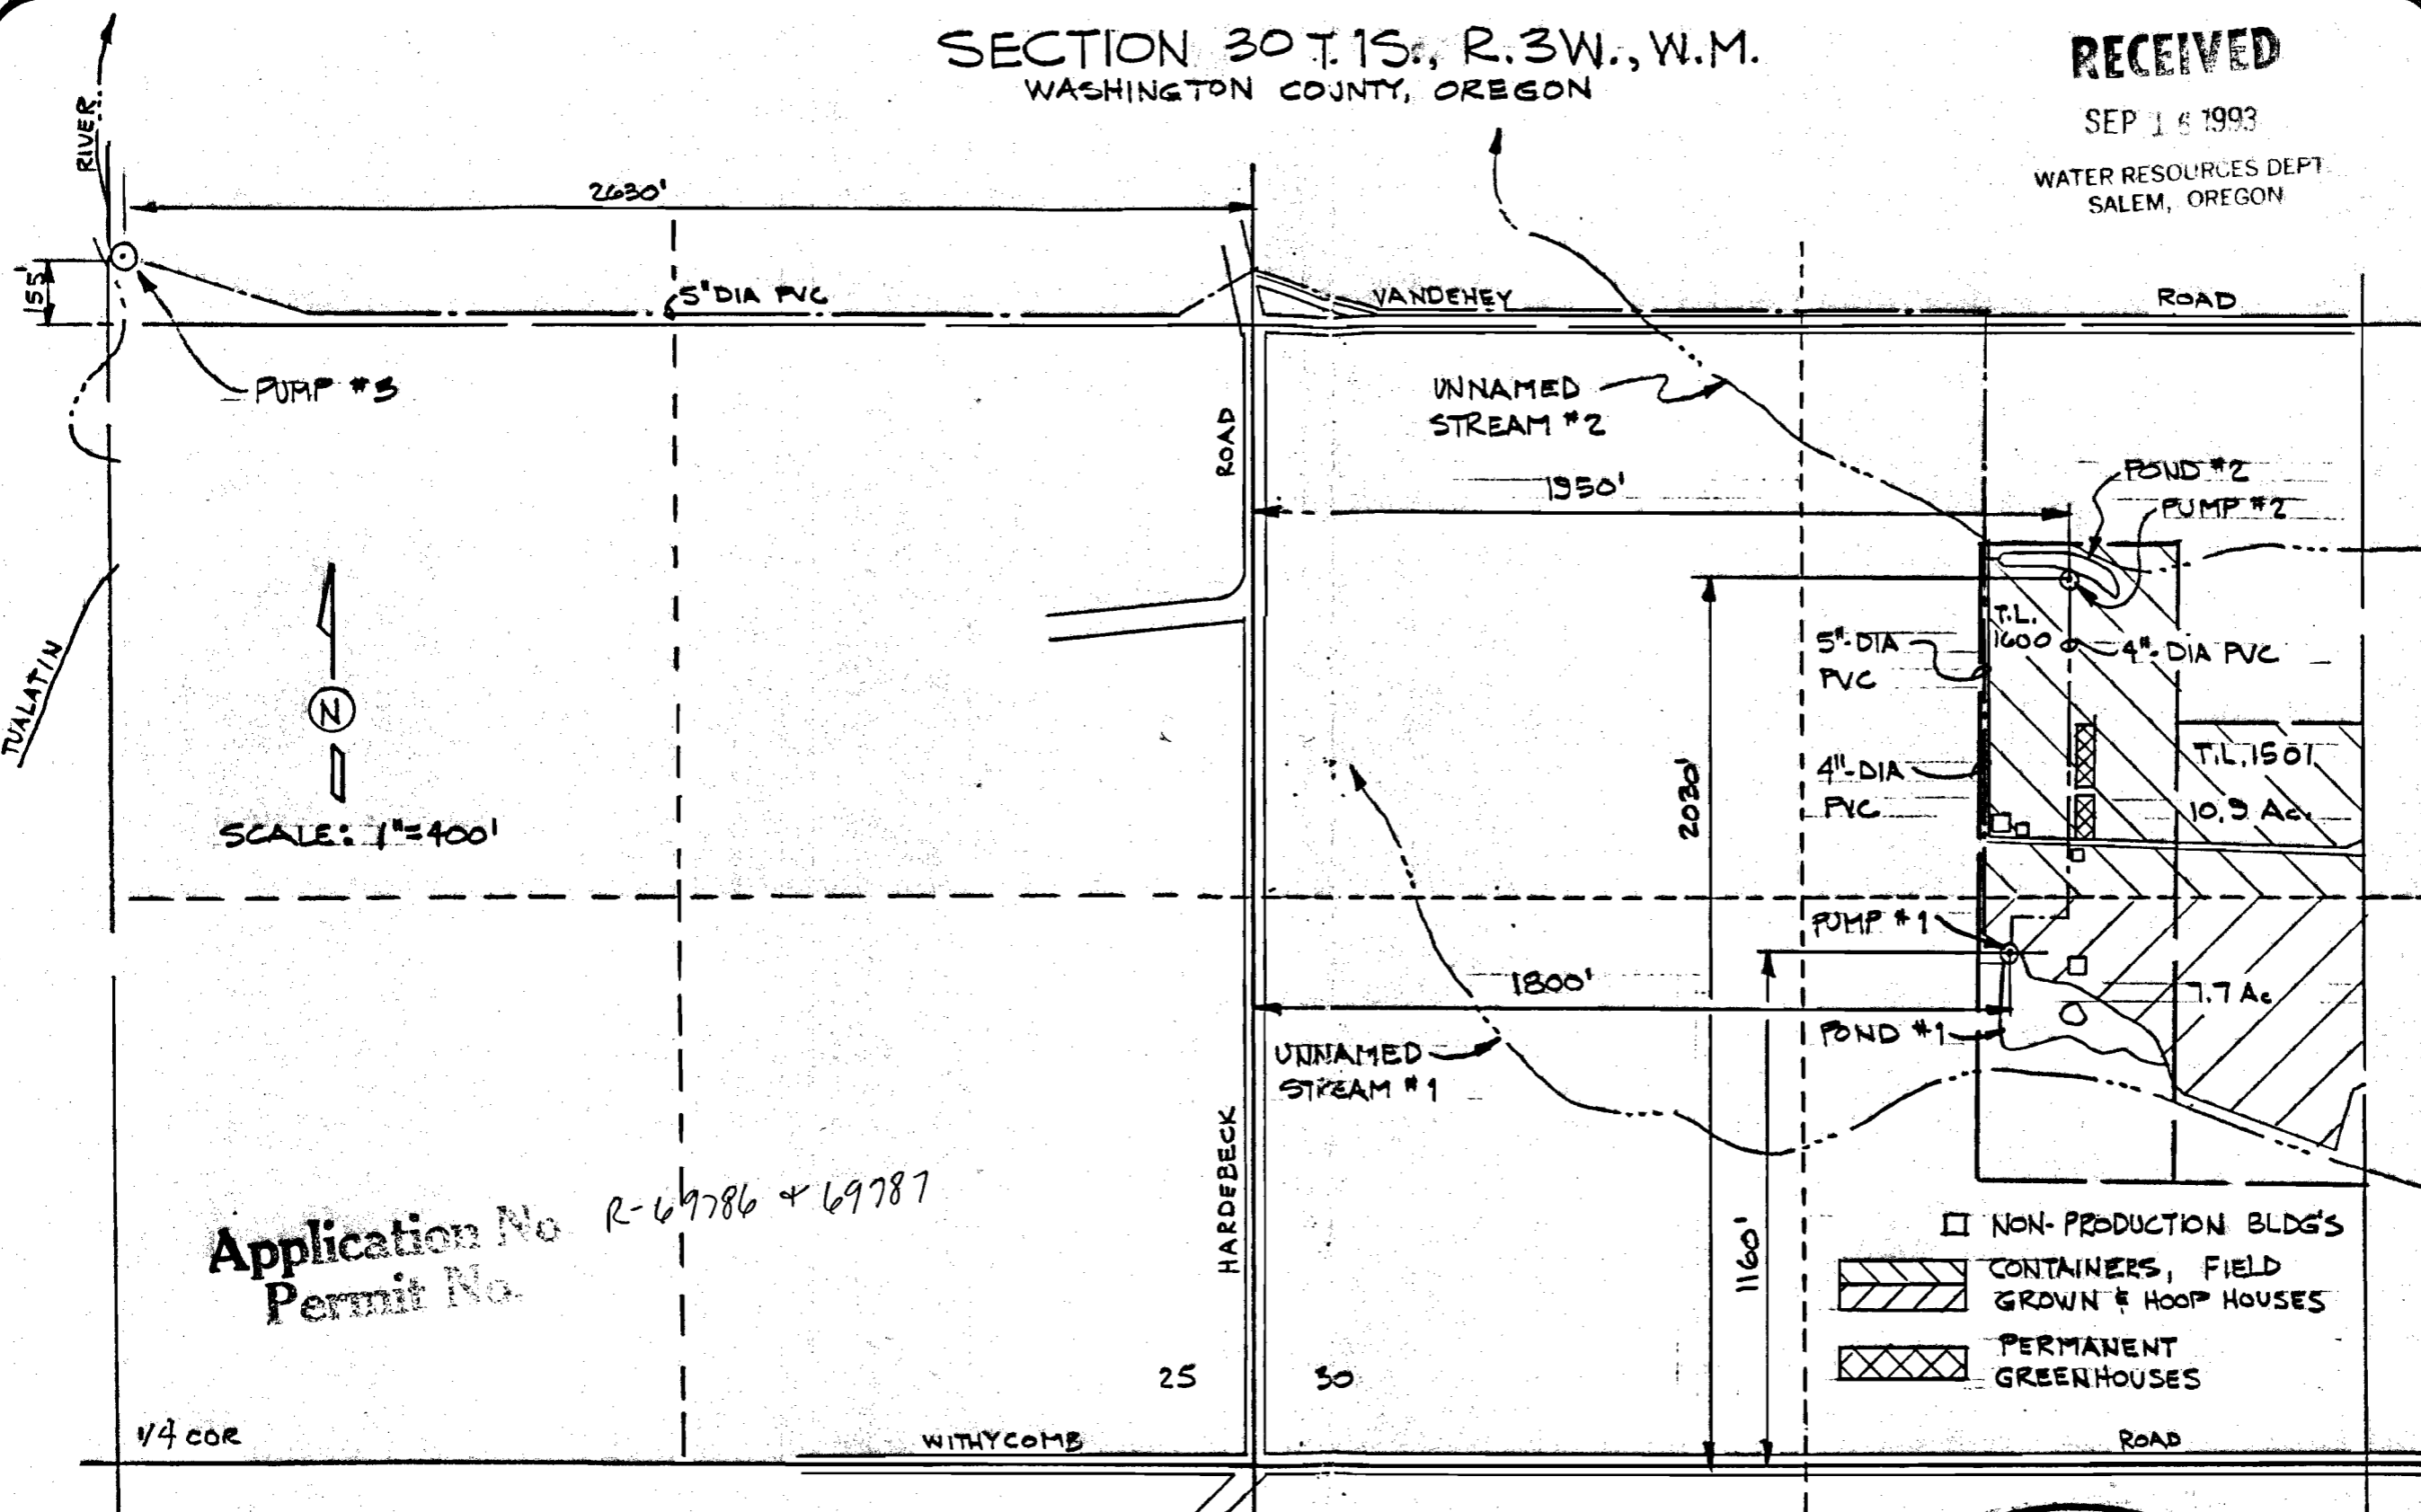

Application No. R-69786 & 69787  
Permit No.

designed	WRV	9-7-93
drawn	JER	9-7-93
checked	WRV	9-7-93
drawing no.	93-B-18	
sheet no.	1/1	

**VERBOORT ENGINEERING**  
AGRICULTURE • CIVIL • WATER RESOURCES  
HILLSBORO, OREGON

PREPARATION OF THIS MAP IS FOR THE PURPOSE OF IDENTIFYING THE LOCATION OF THE WATER RIGHT ONLY. THERE IS NO INTENT TO PROVIDE DIMENSIONS OR LOCATION OF PROPERTY OWNERSHIP LINES.

**FINAL PROOF SURVEY**  
SURVEYED: SEPT 1, 1993  
PERMIT NO'S R-11188, 50805

