
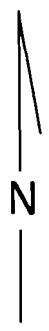


T. 38 S., R. 2 W., W.M.

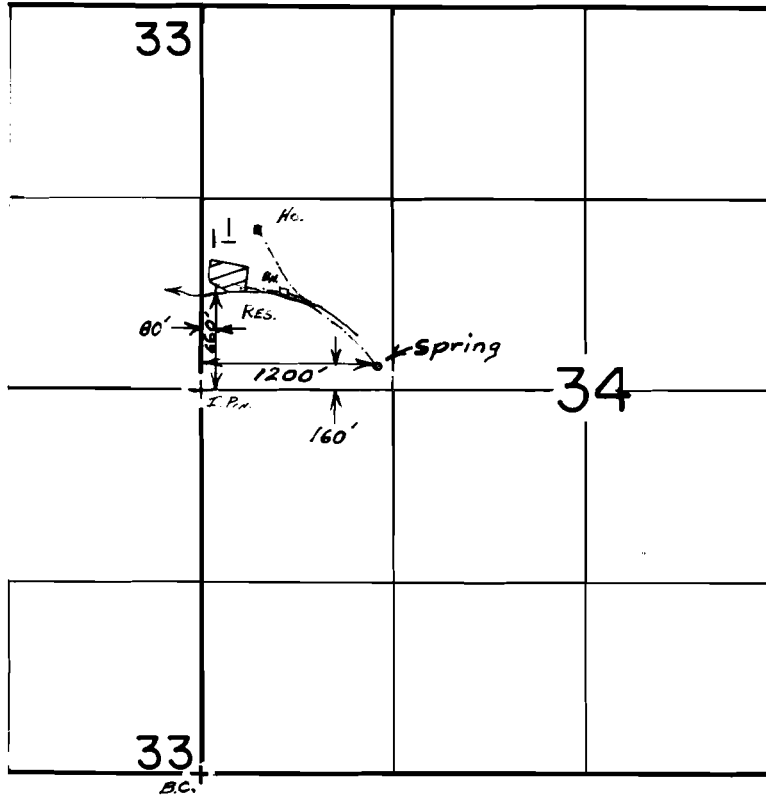

Scale : 1" = 1320'

FINAL PROOF SURVEY
UNDER

R-53903 R-6439
Application No. 53904 Permit No. 40397.....
IN NAME OF

...JAMES... E... PERKINS.....

Surveyed March 30, 1993., by S. DeHaas.....