

FINAL PROOF SURVEY MAP IN THE NAME OF JOHN A. MCMAHON

APPLICATION R-54362
54363


PERMIT R-6495
40691

SECTION 8, TOWNSHIP 29 SOUTH, RANGE 14 WEST, W.M.

RECEIVED

MAR 12 1987

WATER RESOURCES DIVISION
SALFORD, OREGON

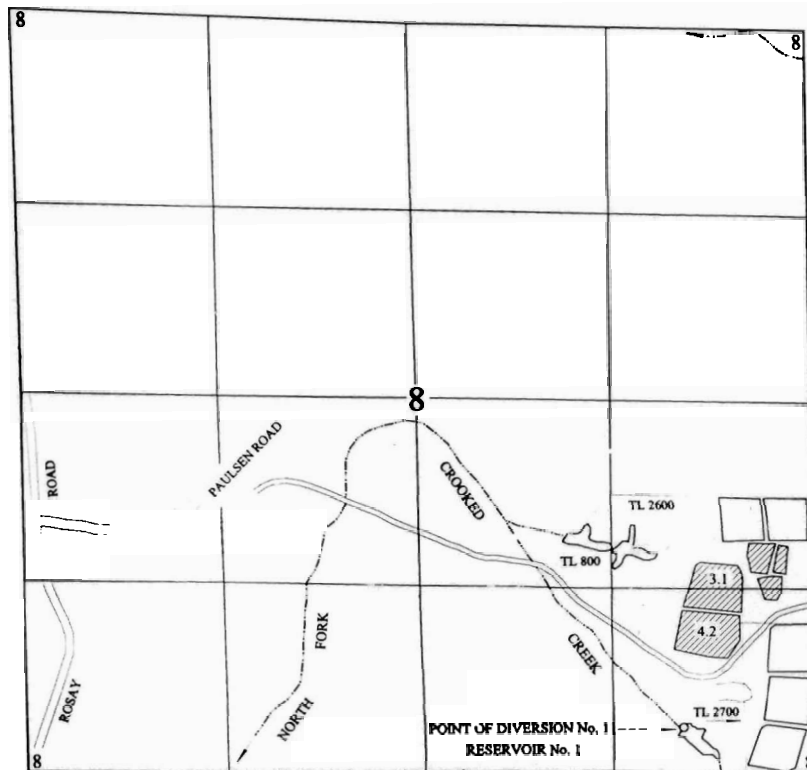

THE POINT OF DIVERSION AND RESERVOIR ARE LOCATED 320 FEET NORTH AND
930 FEET WEST FROM THE SOUTHEAST CORNER OF SECTION 8, BEING WITHIN
THE SE $\frac{1}{4}$ SE $\frac{1}{4}$ OF SECTION 8, TOWNSHIP 29 SOUTH, RANGE 14 WEST, W.M.; COOS COUNTY.

THE PURPOSE OF THIS MAP IS TO IDENTIFY THE LOCATION OF THE WATER RIGHT
IT IS NOT INTENDED TO PROVIDE INFORMATION RELATIVE TO THE LOCATION OF
PROPERTY OWNERSHIP BOUNDARY LINES.

