


SECTION 18, T.27S., R.35E., W.M.

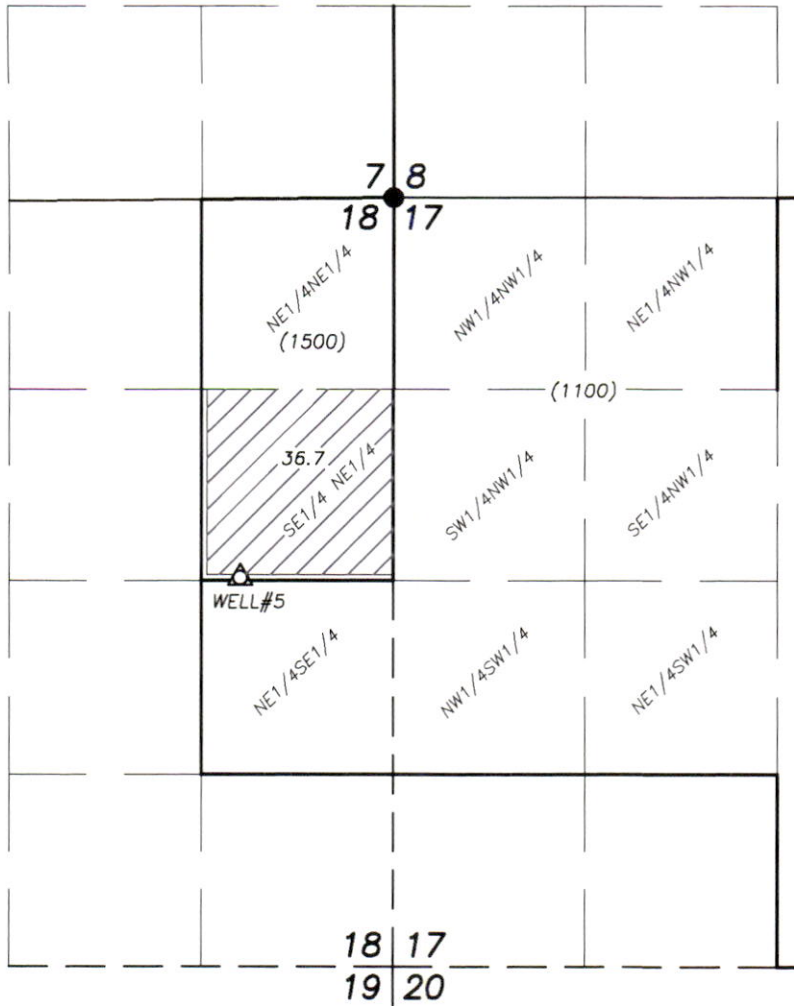

SCALE: 1" = 1320'

CLAIM OF BENEFICIAL USE MAP
UNDER TRANSFER T-13450

IN NAME OF
LOU WILLIAM DAVIES &
MARY JOSEPHINE DAVIES

RECEIVED

JUL 22 2022

OWRD

PREPARED BY:
ROBERT D. BAGETT, PLS, CWRE
217 N. CANYON BLVD.
JOHN DAY, OR 97845
(541) 575-1251


JULY 8, 2022

△ WELL #5 AND METER
2620 FT. SOUTH & 1055 FT. WEST
FROM NE CORNER SECTION 18

▨ PLACE OF USE
PRIORITY DATE: MARCH 14, 1977

● FOUND MONUMENT — NE COR. SEC. 18

() TAX LOT

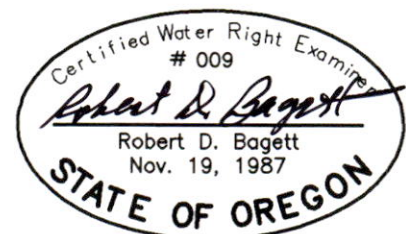

RENEWS: 12/31/2023

DISCLAIMER: THIS MAP IS NOT INTENDED TO PROVIDE LEGAL
DIMENSIONS OR LOCATIONS OF PROPERTY OWNERSHIP LINES.