

# Map for ~~Kee~~ properties reservoir application June 6, 2020


Revised  
Sept 6  
2022  
By JK


Applicant ~~Jeffrey Kee~~ 503-  
939-7939 cp  
[jkee@hevanet.com](mailto:jkee@hevanet.com)  
13642 NW Riverview Dr  
Portland Or 97231-2200

Northern Grant County, East  
Bologna Creek trib to John  
Day River

Point of Diversion  
70 ft South and  
5 ft East of  
NW corner of  
Sec. 5,  
T9S R26E W.M.

Blue Mountain  
Ranchlands LLC

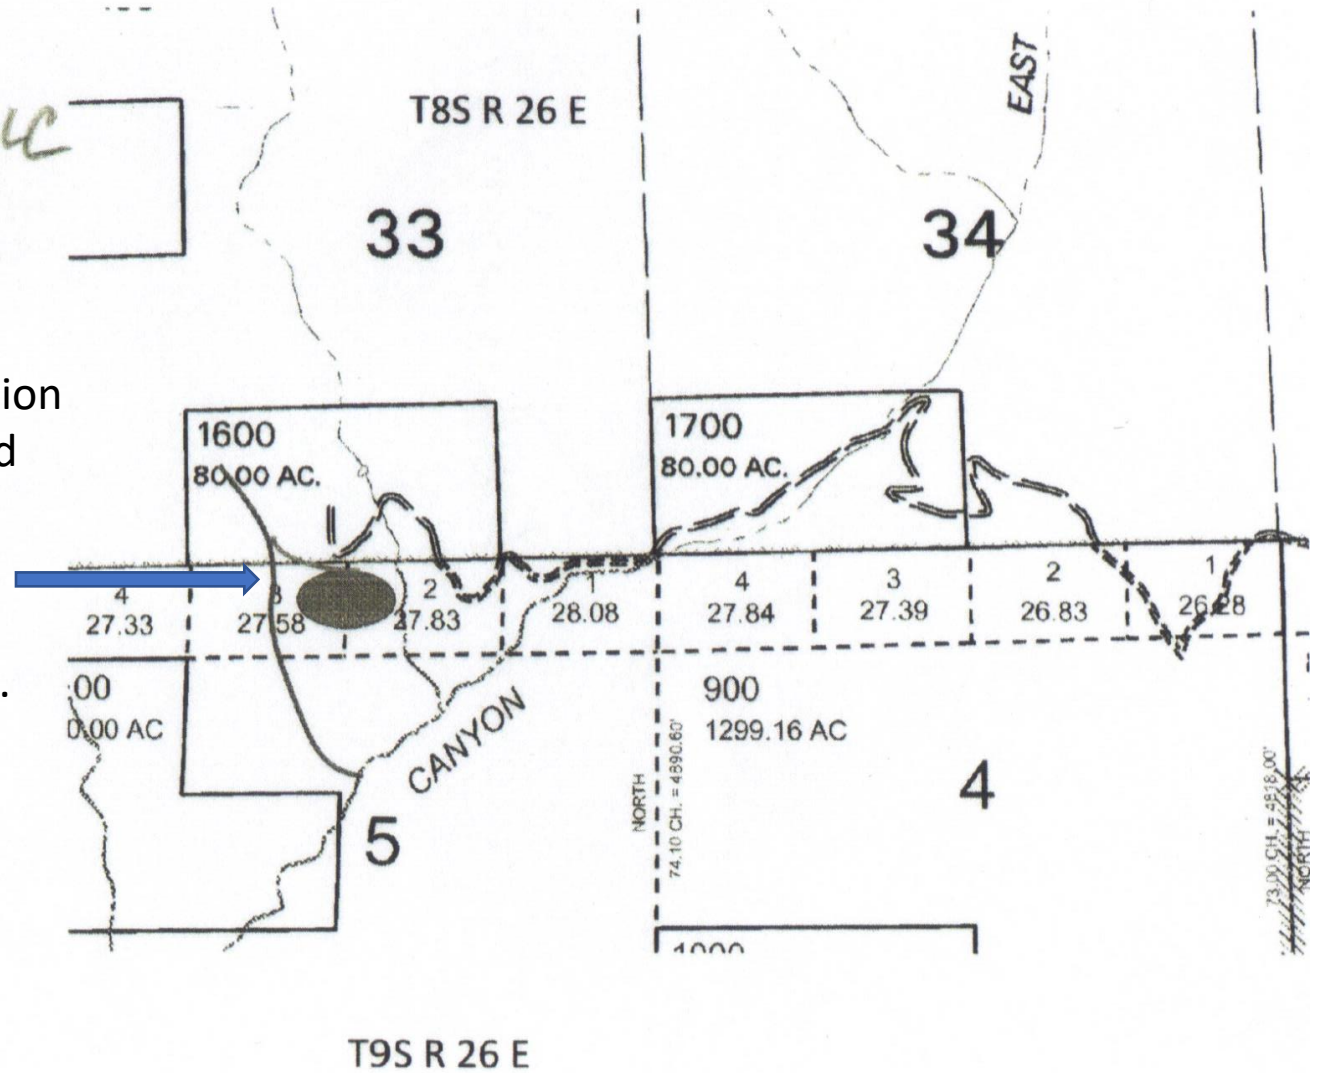

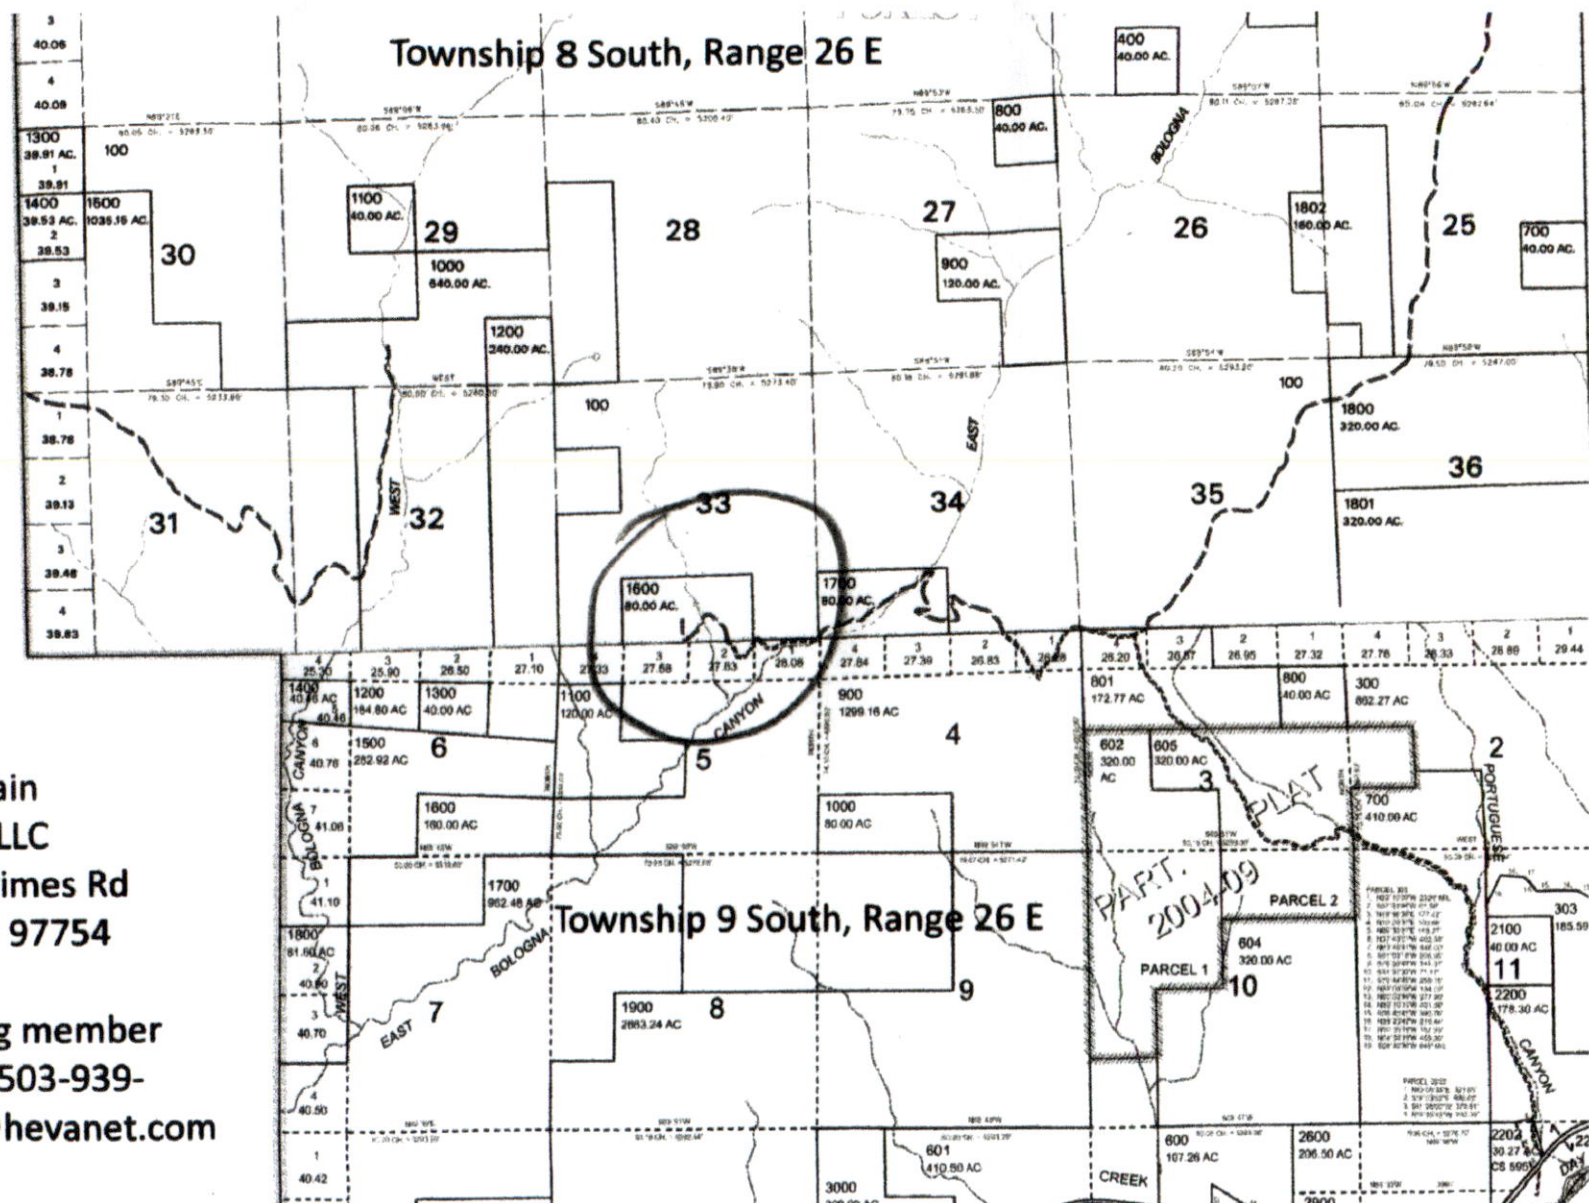

Blue Mountain  
Ranchlands LLC  
4383 NW Grimes Rd  
Prineville Or 97754

Co managing member  
Jeffrey Kee 503-939-  
7939 jkee@hevanet.com



RECEIVED  
JUL 18 2022  
OWRD


RECEIVED  
JUL 29 2022  
OWRD

Map for ~~Kee~~ properties reservoir application June 6, 2020

BLUE MOUNTAIN  
RANCHLANDS LLC

Applicant Jeffrey Kee 503-  
939-7939 cp  
[jkee@hevanet.com](mailto:jkee@hevanet.com)  
13642 NW Riverview Dr  
Portland Or 97231-2200

Northern Grant County, East  
Bologna Creek trib to John  
Day River

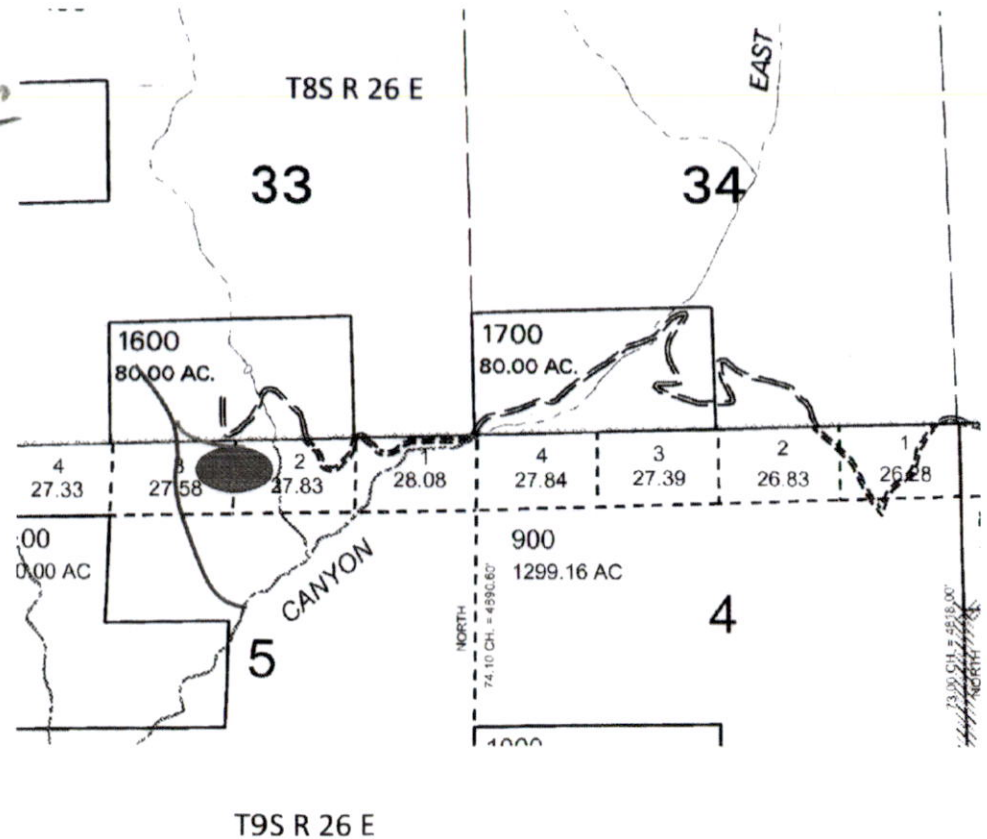

North  
NTS

RECEIVED

JUL 18 2022

OWRD

RECEIVED

JUL 29 2022

OWRD