

CLAIM of BENEFICIAL USE MAP


FOR: TOMMY & PHYLLIS FOX
 BY: NATHAN REED, PE, CWRE
 T26S, R6W, W.M. SECTION 27, DLC 42
 APPLICATION NO. S-87818
 PERMIT NO. S-54823



SCALE: 1" = 400'

DATE OF SURVEY: JULY 26, 2022

RECEIVED
 AUG 01 2022
 OWRD

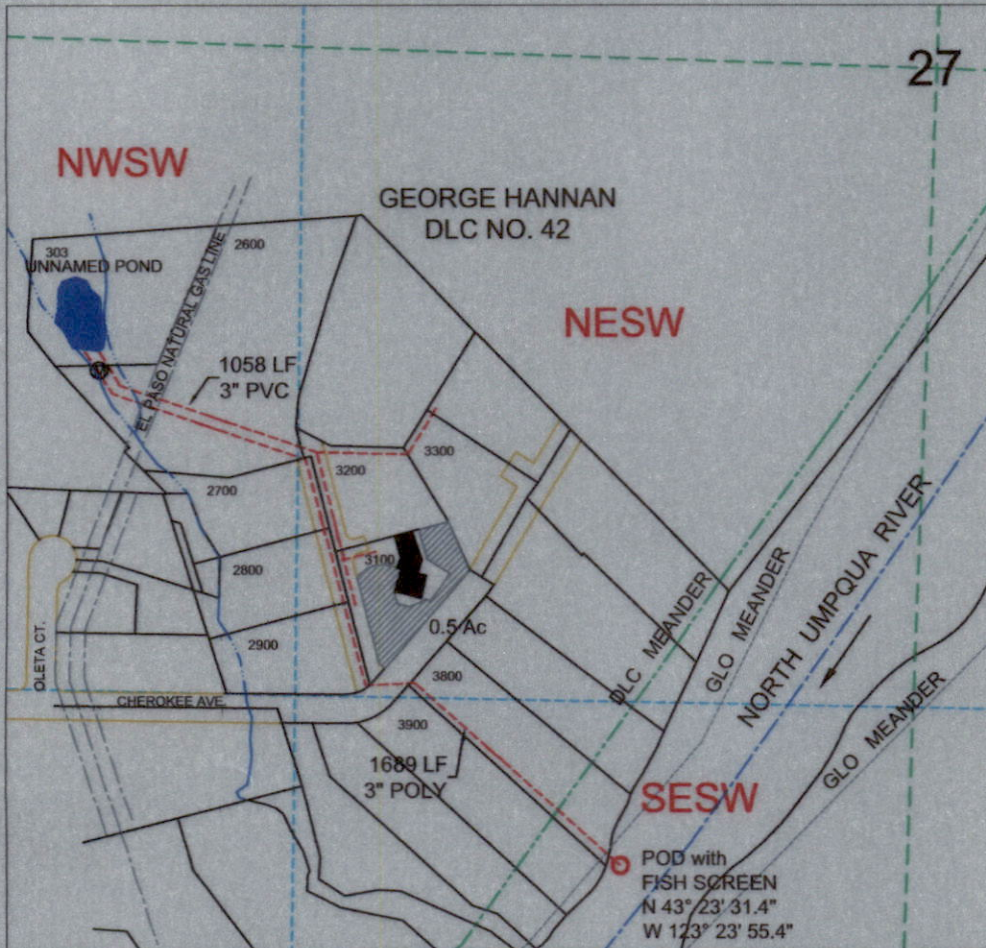


POD IS LOCATED 1640 FEET SOUTH & 635 FEET WEST OF C1/4 CORNER OF SECTION 27, WITHIN DLC NO. 42.

MAP PREPARED FOR:
 TOMMY & PHYLLIS FOX
 640 CHEROKEE AVE
 ROSEBURG, OR 97471

LEGEND

- WATER
- POD
- METER
- PIPE
- QUARTER
- SIXTEENTH
- GLOT
- PARCEL
- IRRIGATION

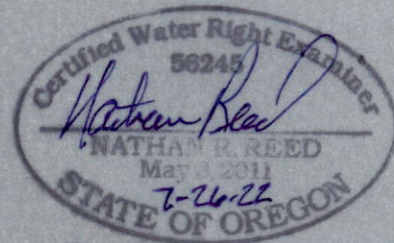

Expires Dec. 31, 2024

THE PURPOSE OF THIS MAP IS TO IDENTIFY THE LOCATION OF THE WATER RIGHT. IT IS NOT INTENDED TO PROVIDE INFORMATION RELATIVE TO THE LOCATION OF PROPERTY OWNERSHIP BOUNDARY LINES.

MAP PREPARED BY:
 NATHAN REED PE, CWRE
 157 WEST BODIE STREET
 ROSEBURG, OR 97471