

FINAL PROOF SURVEY MAP

RECEIVED


IN THE NAME OF DENI AND DALE BORDERS

NOV 18 1987

SECTION 18, T 29 S, R 14 W, W.M.

APPLICATION R-70042  
APPLICATION S-70043

PERMIT R-12062  
PERMIT 52901

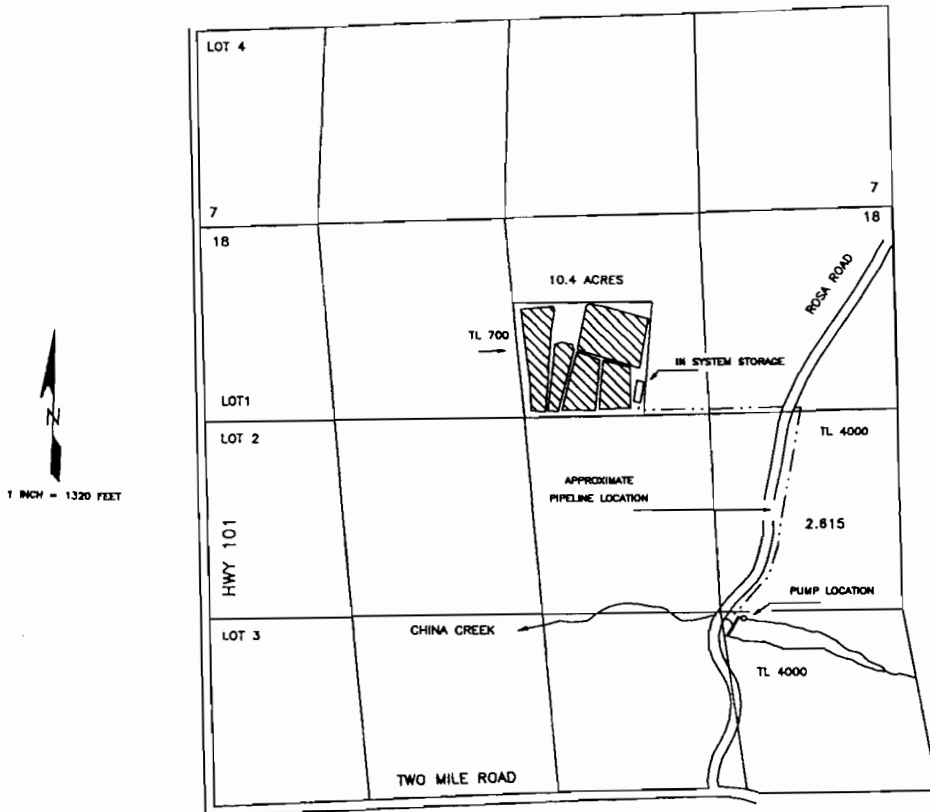

POINT OF DIVERSION	SOUTH	WEST	¼ ¼ SECTION	SECTION
PUMP	2,850 FEET	1,010 FEET	NE¼SE¼	18
RESERVOIR	2,895 FEET	1,080 FEET	NE¼SE¼	18

ALL FROM THE NORTHEAST CORNER OF SECTION 18, BEING WITHIN THE NE¼SE¼ OF SECTION 18, TOWNSHIP 29 SOUTH, RANGE 14 WEST, W.M., COOS COUNTY.

THE PURPOSE OF THIS MAP IS TO IDENTIFY THE LOCATION OF THE WATER RIGHT. IT IS NOT INTENDED TO PROVIDE INFORMATION RELATIVE TO THE LOCATION OF PROPERTY OWNERSHIP BOUNDARY LINES.

