

34 35
3 2


RECEIVED

JUL - 8 1994

WATER RESOURCES DEPT
SALEM, OREGON

N

Section No. R-74287
Parcel No. R11719

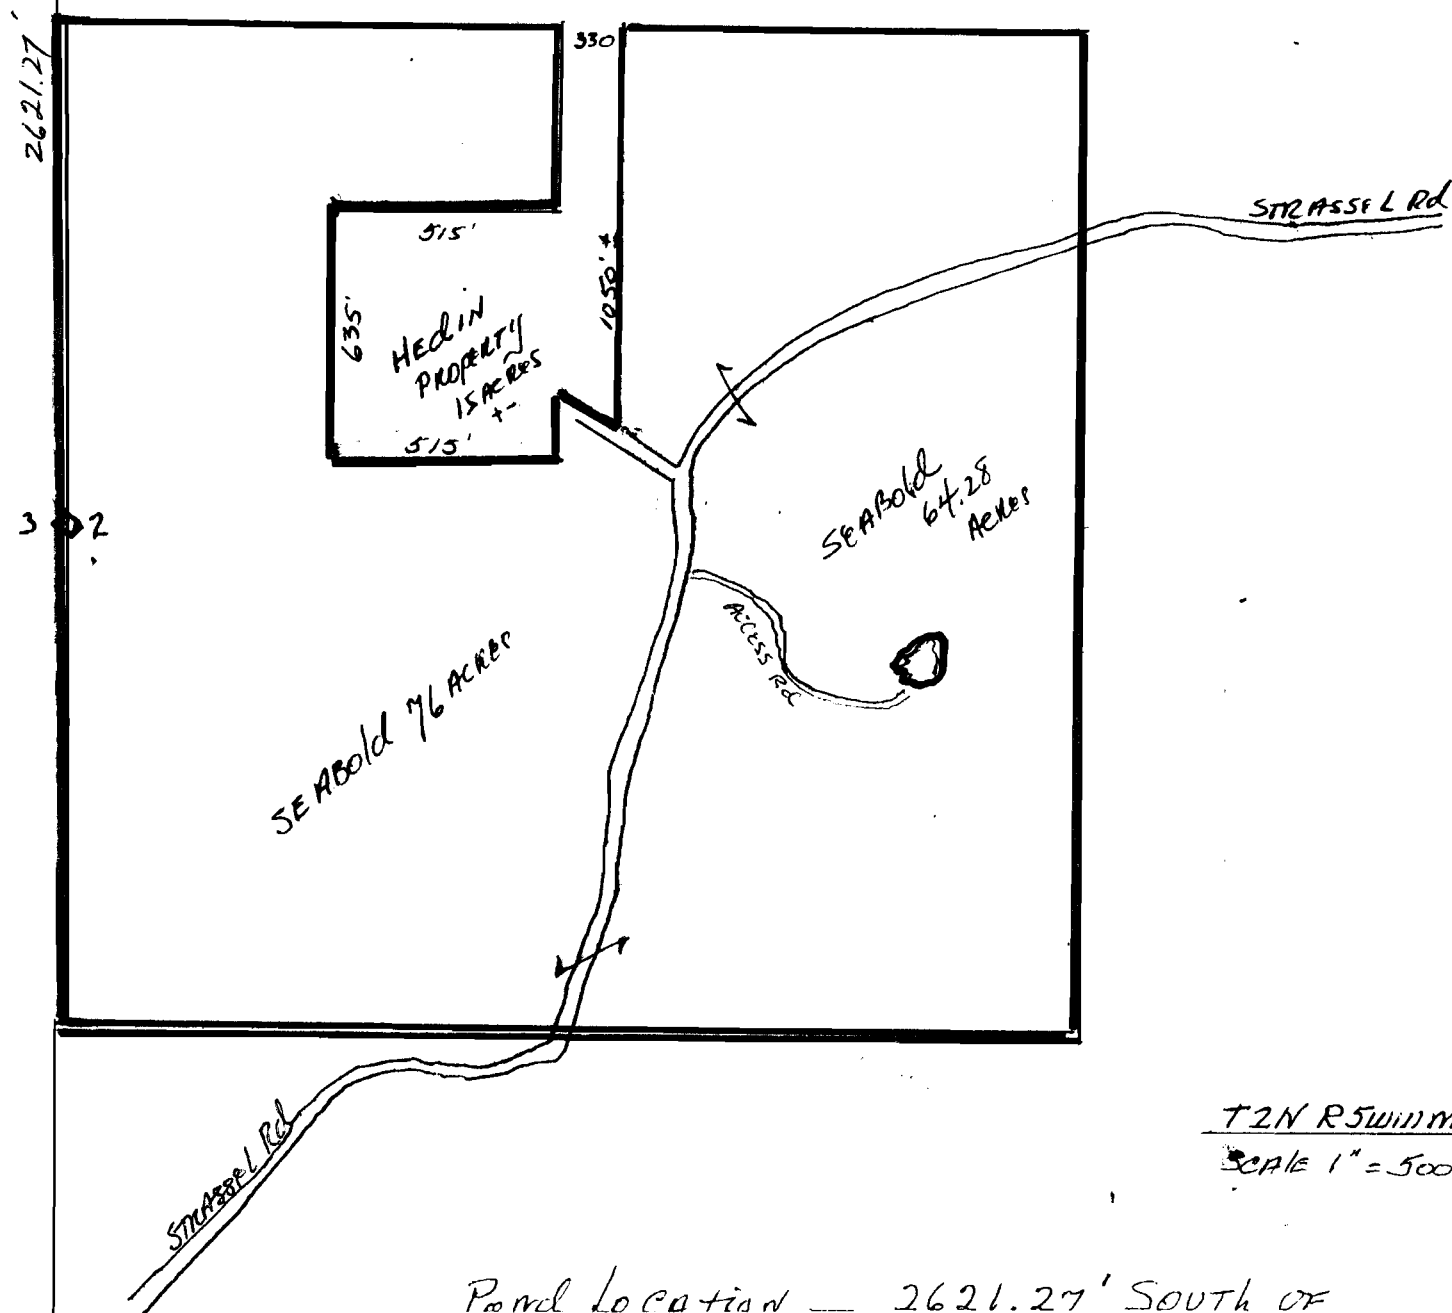

T2N R5W11M
Scale 1" = 500'

- Pond
- ownership

Pond Location — 2621.27' South of
N.W. Corner of Sec 2 T2N5 to East 1/4
Corner of Sec 2. Then East 2200' ± to a
Point. Then South 310' ± to North toe
of Pond.

3 2