



ATTACHMENT 1B
Claim of Beneficial Use Application
Place of Use Map - City of Wilsonville

Application: G - 11344 / Permit: G - 10515
 T3S, R1W

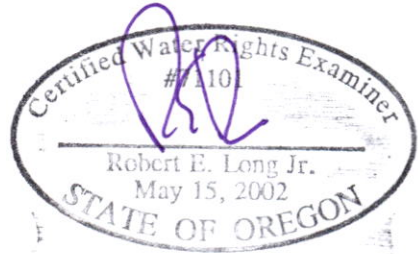


EXPIRATION DATE: 12-31-22

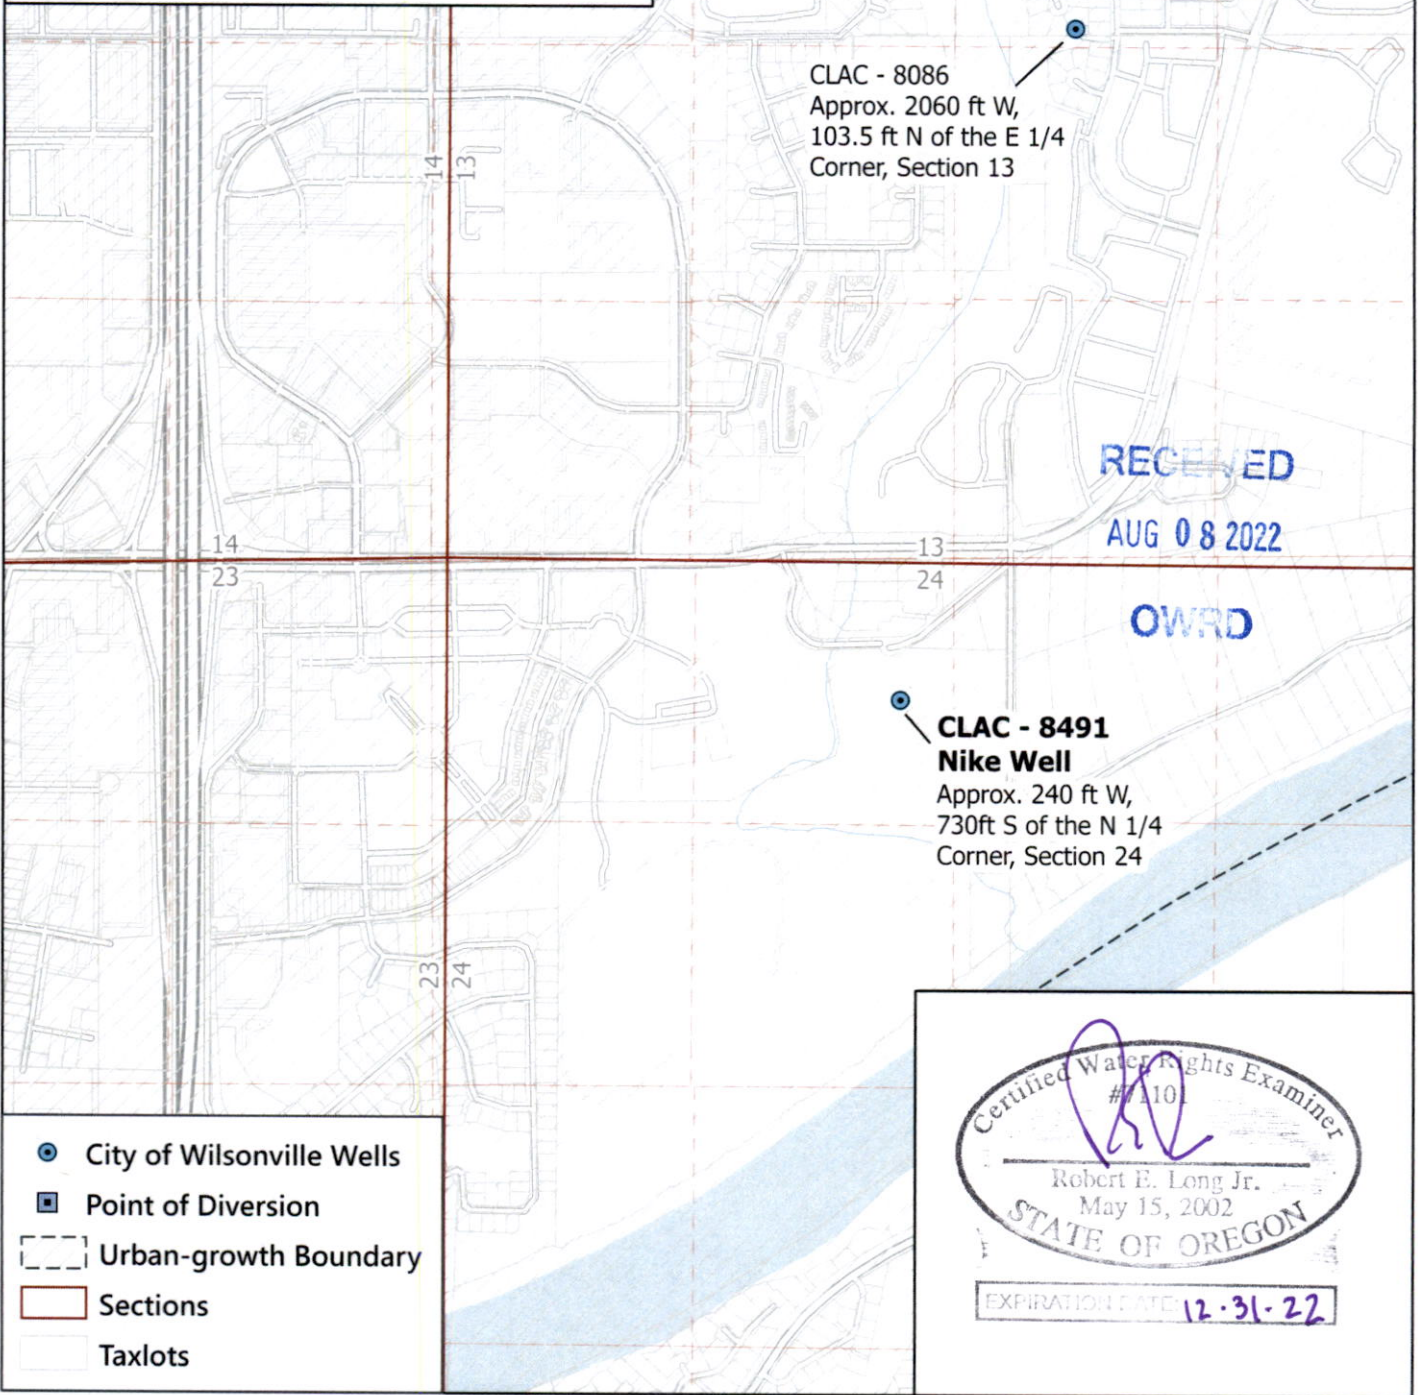

1319 SE MLK, Jr. Blvd, Suite 204
 Portland, Oregon 97214
 (503) 954-1326

This map is not intended to provide legal dimensions or locations of property ownership lines.

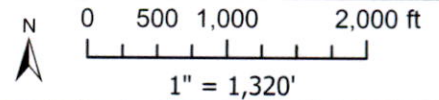


No.	Date	By	Revisions
1	DATE	AUTH	DRAFT
1	10/27/20	IAG	DRAFT 1
2	05/19/21	IAG	FINAL

Proj#: 1707002
City of Wilsonville
 City of Wilsonville
 30000 SW Town Center Loop E
 Wilsonville, OR 97070

ATTACHMENT 1A Claim of Beneficial Use Application Place of Use Map - City of Wilsonville

Application: G - 11344 / Permit: G - 10515
T3S, R1W

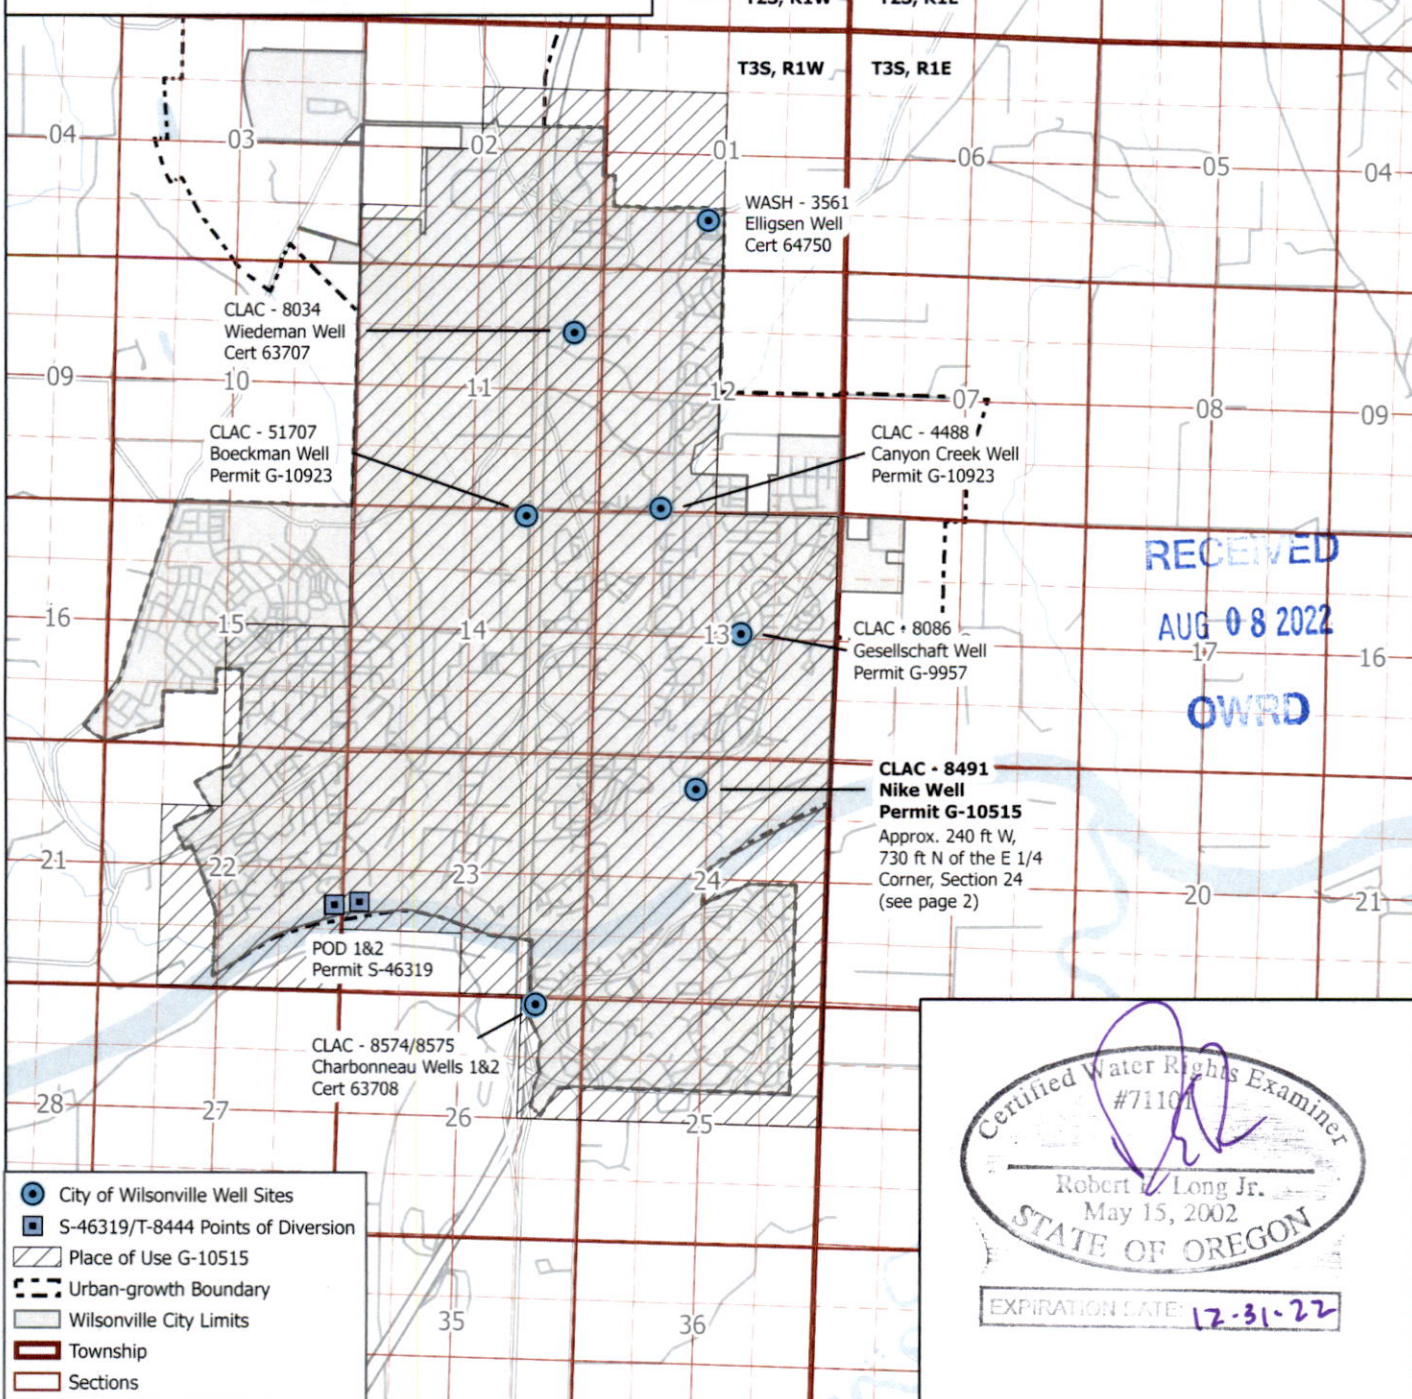


- City of Wilsonville Well Sites
- S-46319/T-8444 Points of Diversion
- Place of Use G-10515
- Urban-growth Boundary
- Wilsonville City Limits
- Township
- Sections

CWM-H2O
Complete Water Management

1319 SE MLK, Jr. Blvd, Suite 204
Portland, Oregon 97214
(503) 954-1326

This map is not intended to provide legal dimensions or locations of property ownership lines.

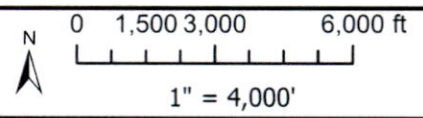

No.	Date	By	Revisions
1	DATE	AUTH	DRAFT
1	10/27/20	IAG	DRAFT 1
2	05/19/21	IAG	FINAL

Proj#: 1707002
City of Wilsonville
City of Wilsonville
30000 SW Town Center Loop E
Wilsonville, OR 97070