


FINAL PROOF SURVEY MAP

IN THE NAME OF JOE L. AND SALLY MOYA

SECTION 32, T 28 S, R 14 W, W.M.

APPLICATION R 70050
APPLICATION 70051

PERMIT R 11227
PERMIT 50975

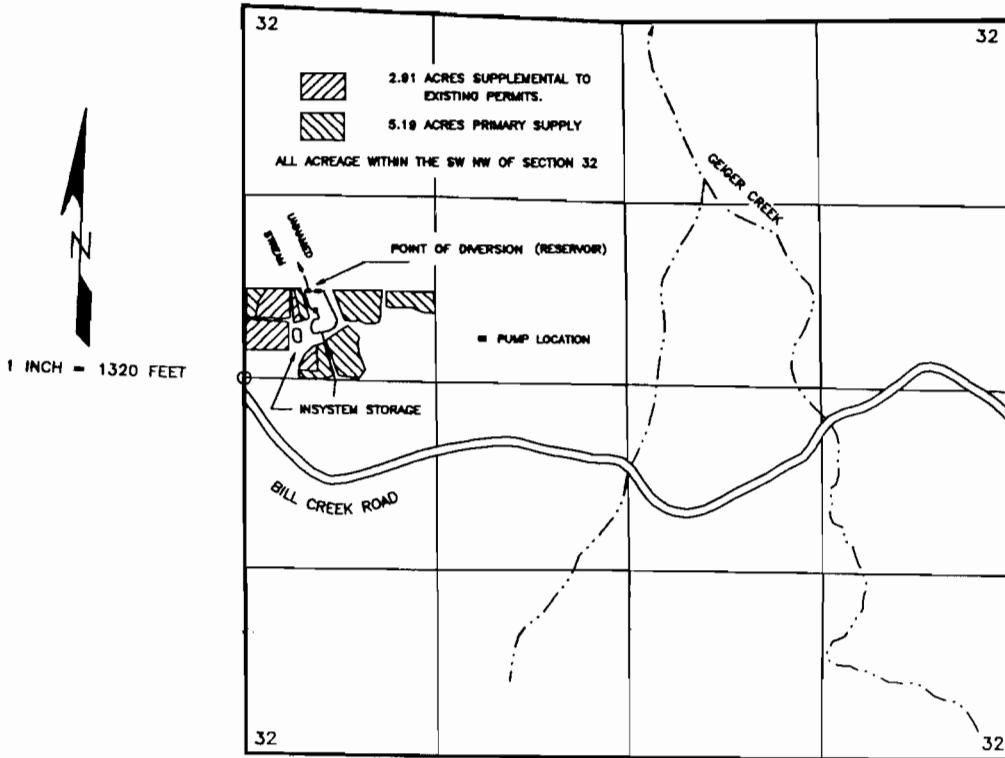

THE POINT OF DIVERSION (RESERVOIR OUTLET) IS LOCATED 610 FEET NORTH AND 430 FEET EAST FROM THE WEST QUARTER CORNER OF SECTION 32; BEING WITHIN THE SW $\frac{1}{4}$ NW $\frac{1}{4}$ OF SECTION 32, TOWNSHIP 28 SOUTH, RANGE 14 WEST, W.M.; IN COOS COUNTY.

PUMP No. 1 IS LOCATED 475 FEET NORTH AND 480 FEET EAST AND PUMP No. 2 IS LOCATED 610 FEET NORTH AND 500 FEET EAST BOTH FROM THE WEST QUARTER CORNER OF SECTION 32; BEING WITHIN SECTION 32, TOWNSHIP 28 SOUTH, RANGE 14 WEST, W.M.; IN COOS COUNTY.

THE PURPOSE OF THIS MAP IS TO IDENTIFY THE LOCATION OF THE WATER RIGHT. IT IS NOT INTENDED TO PROVIDE INFORMATION RELATIVE TO THE LOCATION OF PROPERTY OWNERSHIP BOUNDARY LINES.

