

Application No. 12-742  
Permit No.

RECEIVED


JUL - 6 1994

WATER RESOURCES DEPT.  
SALEM, OREGON

RECEIVED

JUL 6 1994

WATER RESOURCES DEPT.  
SALEM, OREGON

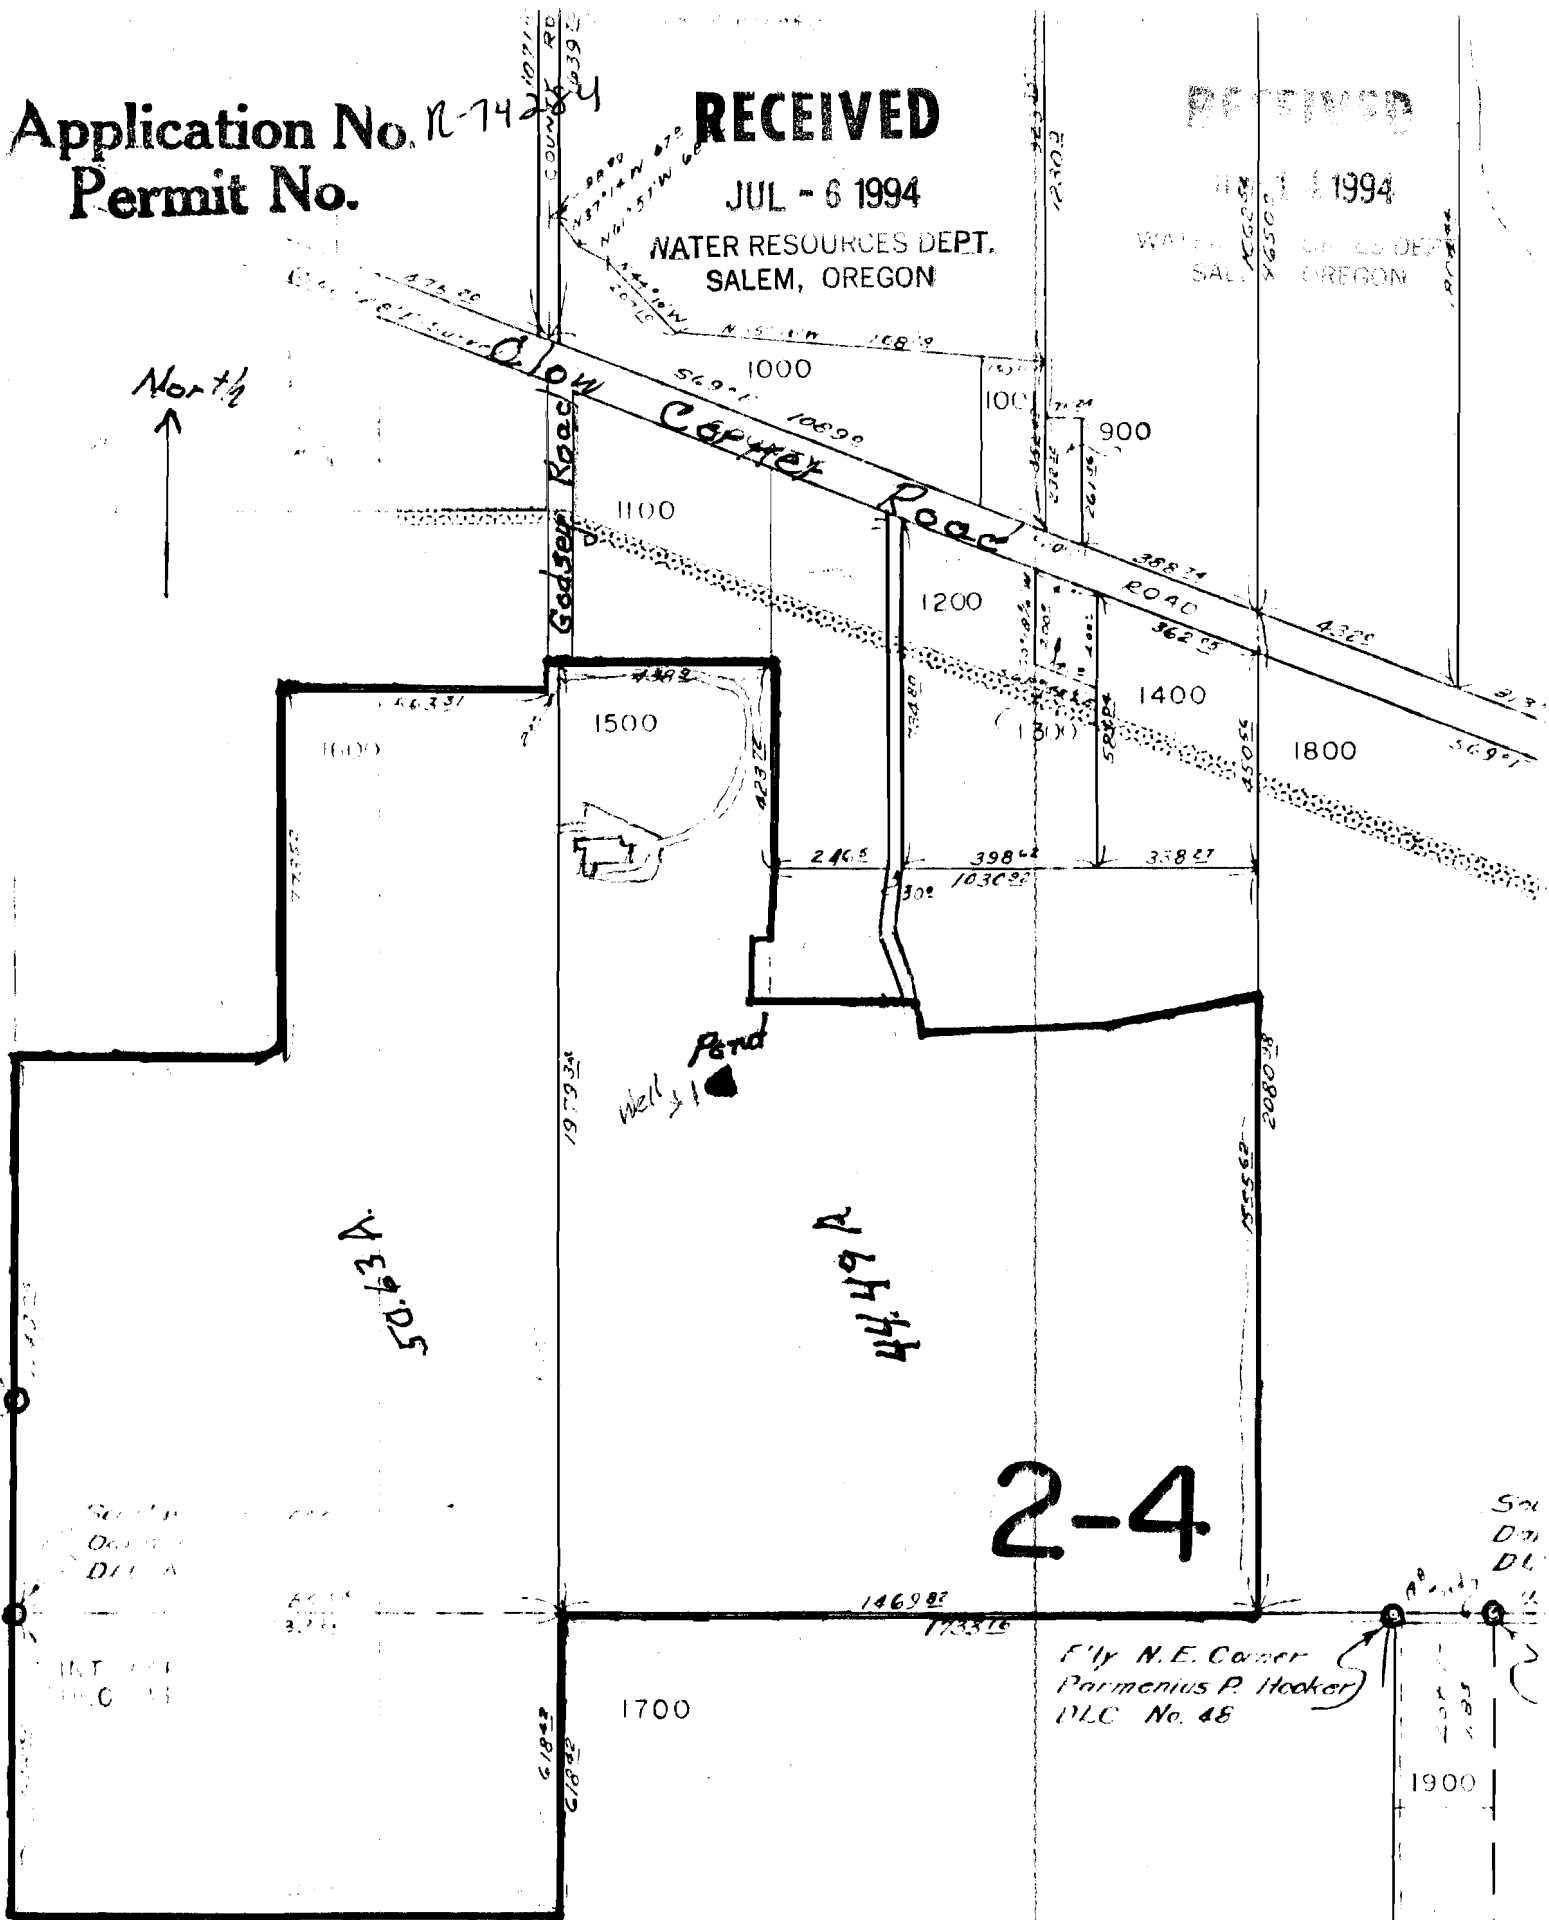

50.63 A

44.49 A

2-4

Ely N.E. Corner  
Parmenius P. Hooker  
PLC No. 48

1700

1900