

ELLEN WARD
2580 UPPER SMITH RIVER RD
DRAIN, OR 97435

APPLICATION NO. S-86087

PERMIT NO. S-54174


SITUATED IN
SECTION 30, TOWNSHIP 21 S
RANGE 5 W, W.M.
DOUGLAS COUNTY OREGON

LEGEND

● UNNAMED SPRING
250' NORTH and 1370' WEST
OF SOUTHEAST CORNER
SECTION 30, T21S R5W

○ PLACE OF USE

— -- PIPELINE

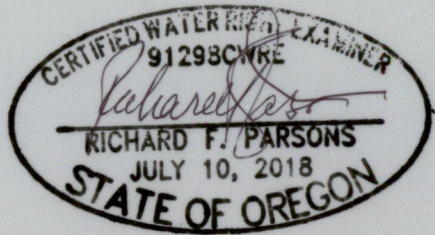

TL 1200

METER AND
STORAGE TANK

SE CORNER
SECTION 30

FITCH CREEK

30

29

31

32

This map is not intended to provide
legal dimensions or locations of
property ownership lines

ParsonsWater Consulting LLC
rick.parsons@parsonwater.com
541.499.0257 303.667.5067

300 600 ft

RECEIVED
JUL 28 2022
OWRD

RECEIVED
AUG 12 2022
OWRD